RECEIVED
DEC 0 9 1999
WATER RESOURCES DEPT
SALEM, OREGON

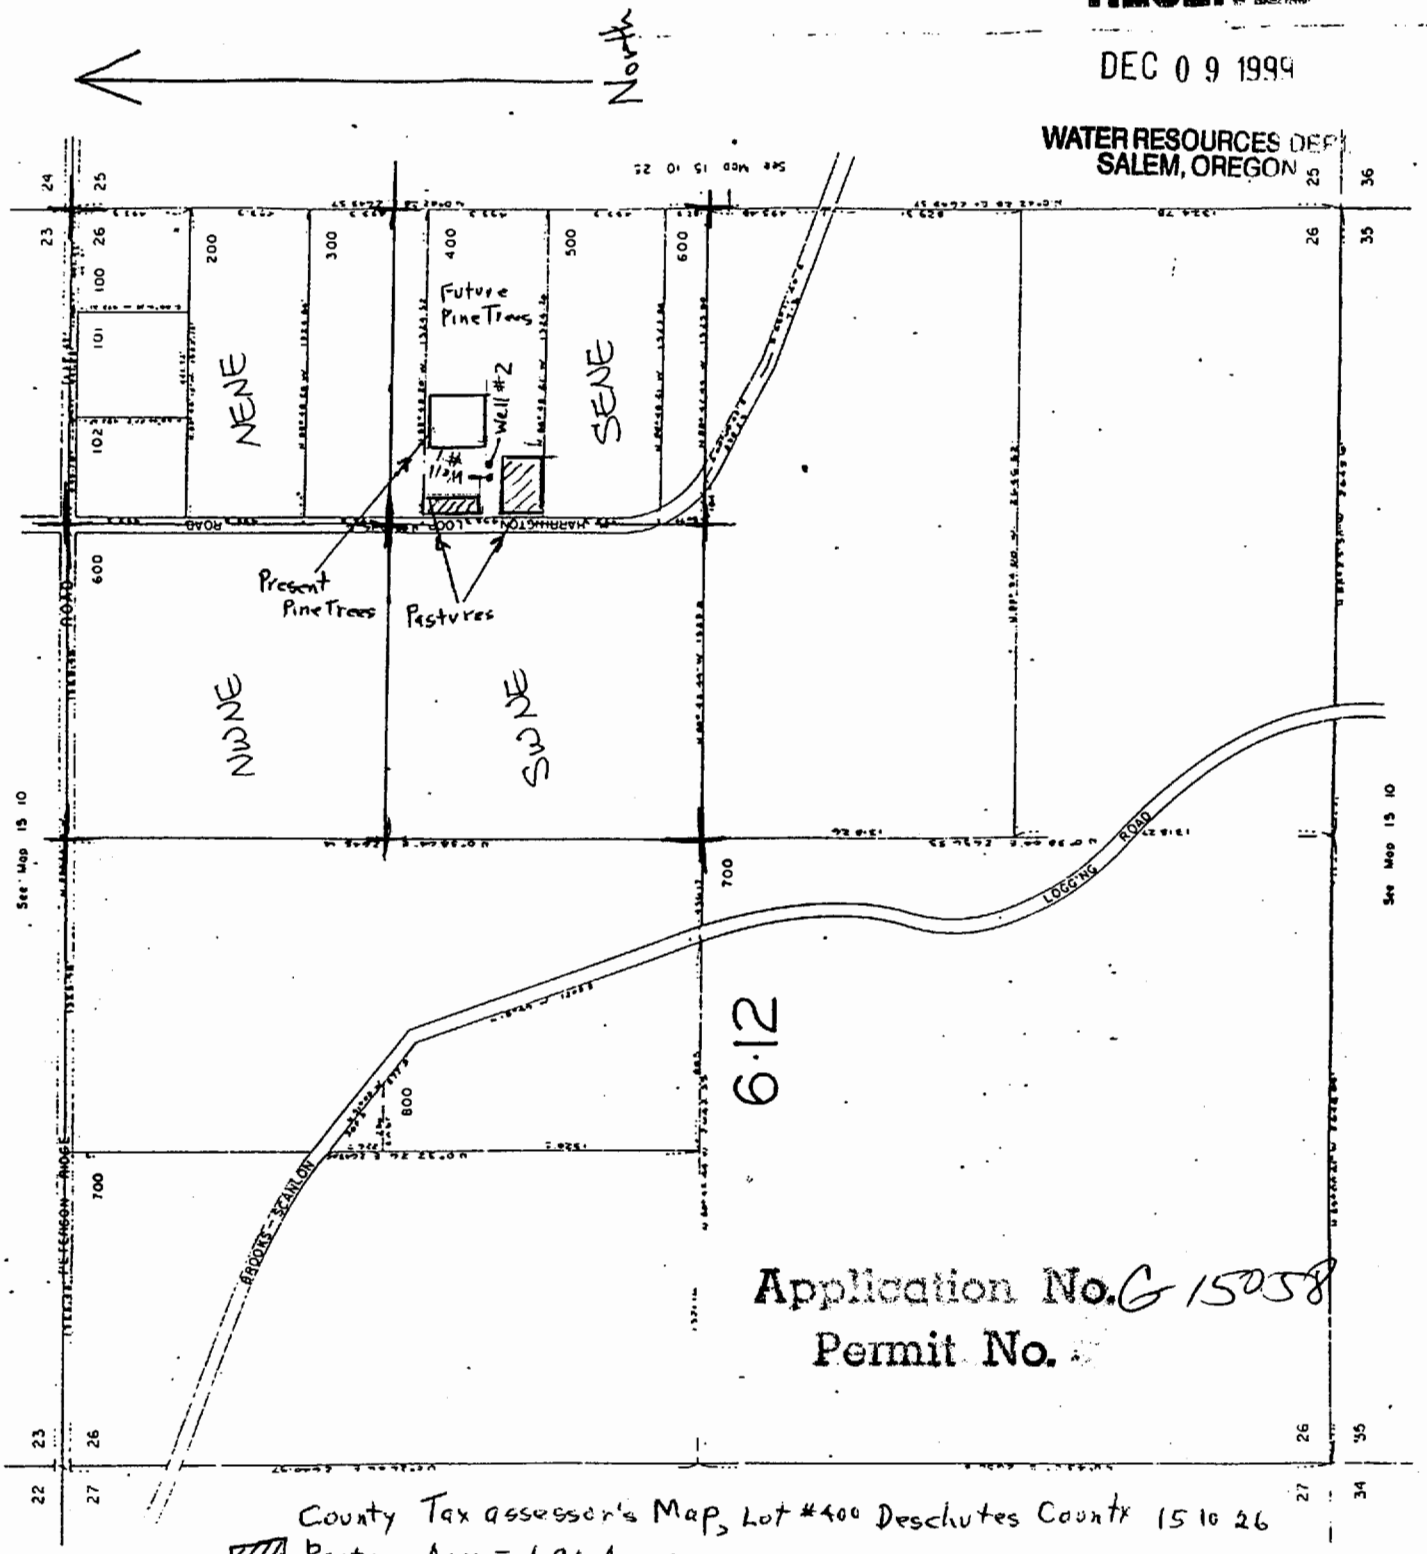

County Tax assessor's Map, Lot #400 Deschutes County 15 10 26

▨ = Pasture Area = 1.94 Acres

P.O.D. - Well #1 = 1780' South 1086' West from the NE Corner section 26

Well #2 = 1780' south 1080' west from the NE corner Sec.

SCALE 1:9600

RECEIVED
OCT 2 8 1999
WATER RESOURCES DEPT.
SALEM, OREGON

Permit No. G-15622