


RIW

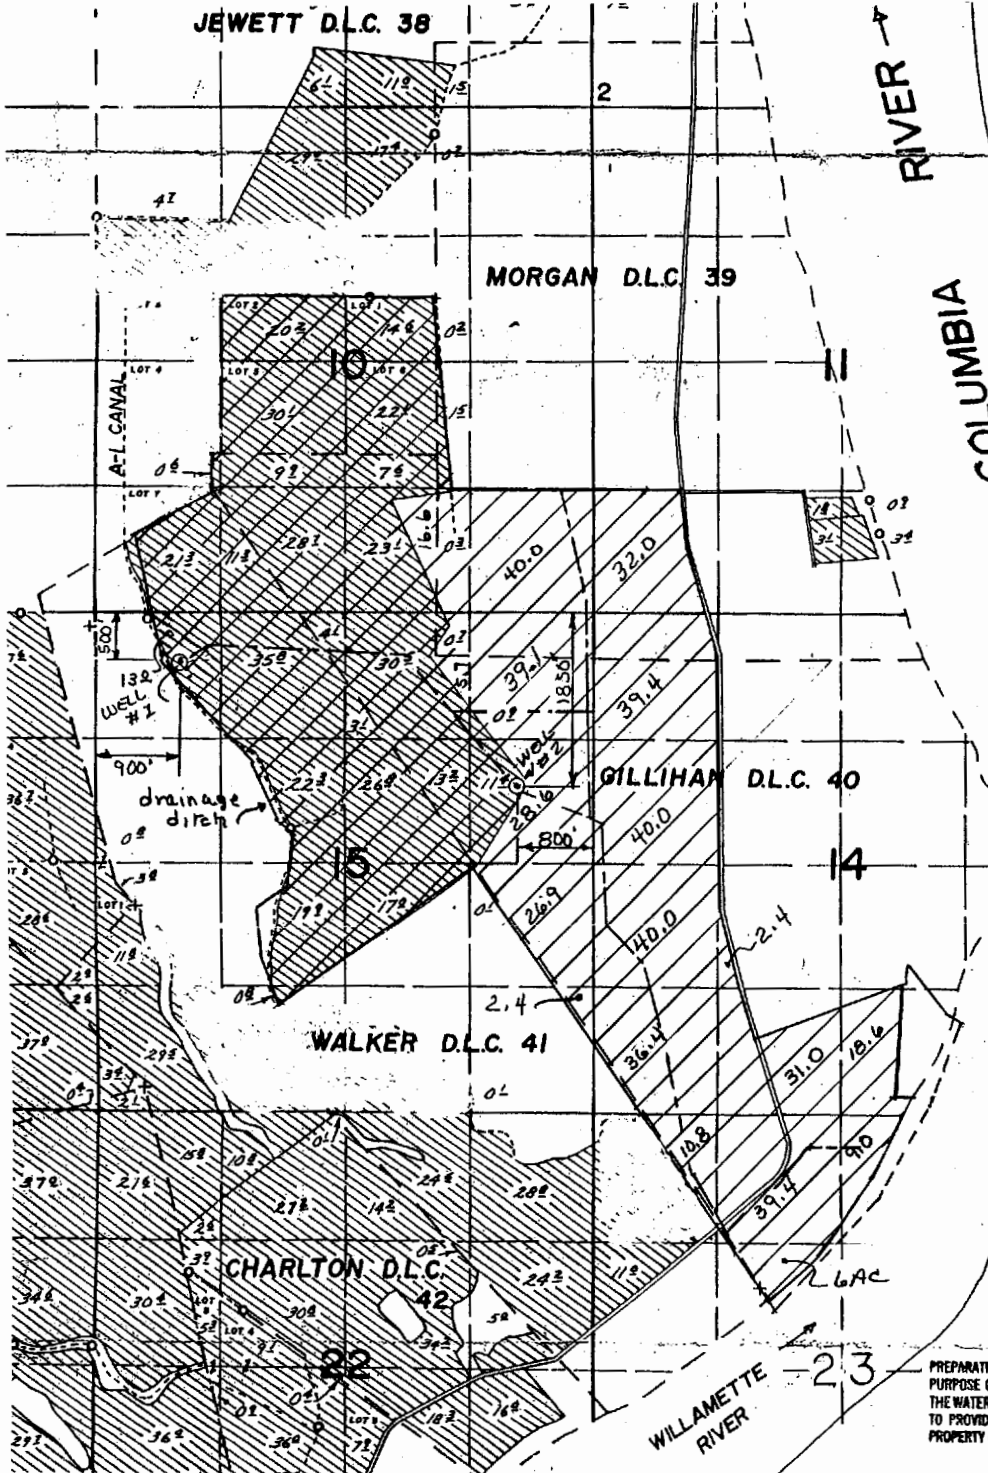

PREPARATION OF THIS MAP IS FOR THE PURPOSE OF IDENTIFYING THE LOCATION OF THE WATER RIGHT ONLY. THERE IS NO INTENT TO PROVIDE DIMENSIONS OR LOCATION OF PROPERTY OWNERSHIP LINES.

RECEIVED

JUN 26 2003



THIS APPLICATION

Scale: 1" = 1320'



CERTIFICATE 49880 (TYPICAL)

MAP BASE: ODWR Cert Map for 49880



VERBOORT ENGINEERING
 AGRICULTURE • CIVIL • WATER RESOURCES
 HILLSBORO, OREGON

by date
 designed RV 6-18-03
 drawn RV 6-18-03
 checked _____
 drawing no. 03-B-11
 sheet no. 1/1

GROUNDWATER APPLICATION
 BAILEY NURSERIES, INC.
 SAUVIE ISLAND DIVISION
 18616 N. W. REEDER ROAD
 PORTLAND, OR 97231

app no G-16039

Permit NO. 15-15632