



WORK COPY

# APPLICATION MAP FOR GROUND WATER RIGHTS

IN THE NAME OF

## HEWLETT-PACKARD

LOCATED IN SEC. 25, T.11S., R.05W., W.M.

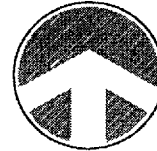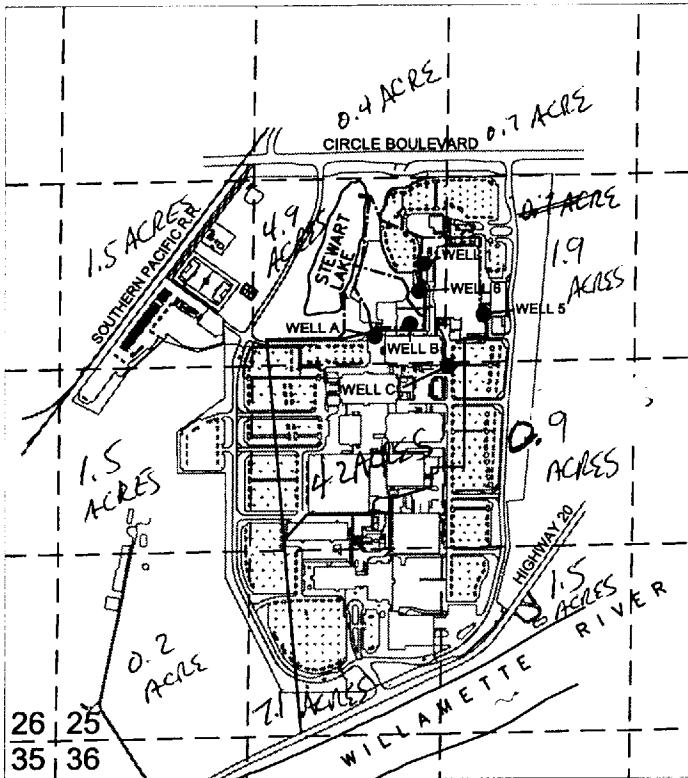

1" = 1320'

## LEGEND

INDUSTRIAL POINT OF USE AREA

—— STORM DRAIN FEED

--- LAKE SUPPLY FEED

● WATER SUPPLY WELL

--- 1/4 1/4 SECTION LINE

TAX LOT AREA #1202

WELL DISTANCES IN FEET FROM THE  
NE CORNER OF THE  
SE 1/4 NW 1/4 SECTION 25:

WELL 1 WEST 150', SOUTH 595',  
WELL 5 EAST 257', SOUTH 945'  
WELL 6 WEST 179', SOUTH 780'  
WELL A WEST 480', SOUTH 1085'  
WELL B WEST 239', SOUTH 1013'  
WELL C EAST 18', SOUTH 1300'

THIS MAP WAS PREPARED FOR THE PURPOSE OF  
IDENTIFYING THE LOCATION OF A WATER  
RIGHT ONLY AND IS NOT INTENDED TO PROVIDE  
LEGAL DIMENSIONS OR LOCATION OF PROPERTY  
OWNERSHIP LINES