


APPLICANT:  
 JOEL NEUSCHWANDER  
 6097 S. WHISKEY HILL Rd.  
 HUBBARD, OR 97032  
 (503) 651-3253

T. 4 S., R. 1 E., W.M.  
 SECTION 32

N  
 ↑  
 ↓  
 T

(1" = 1320')

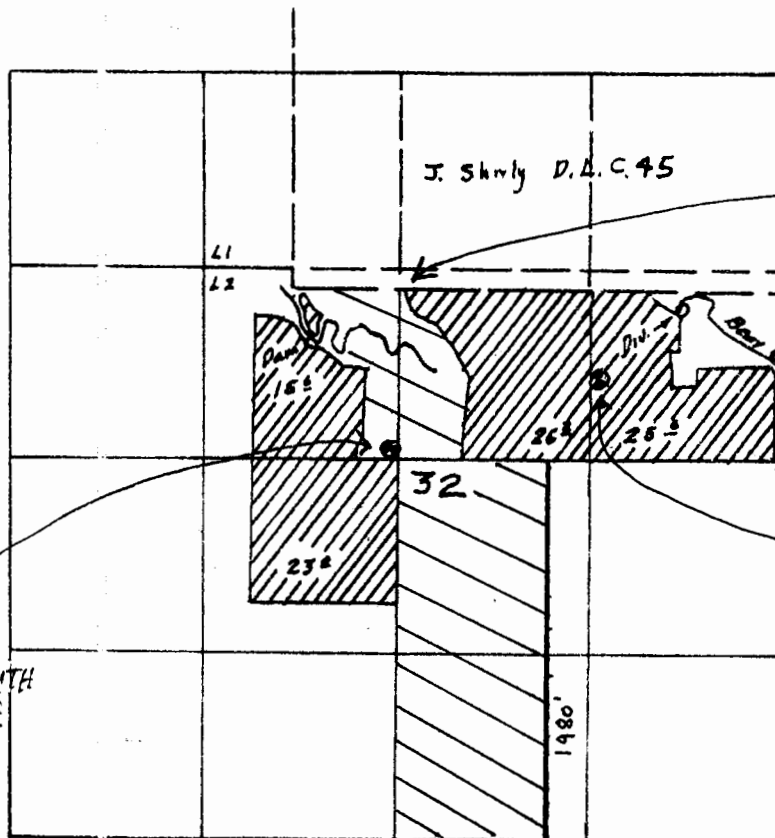

AREA TO BE IRRIGATED IN  
 TAX LOT 900:  
 13.8 acres in  
 SW 1/4 NE 1/4  
 PLUS 24.4 acres  
 in SE 1/4 NW 1/4.  
 TOTAL: 37.4 acres

WELL No. 1 is  
 1,250' from the  
 EAST LINE of the  
 SECTION (32), AND  
 550' from the  
 SOUTH LINE of the  
 SE 1/4 NE 1/4 Sec. 32

WELL No. 2  
 is 50' WEST & 50' SOUTH  
 of the SE CORNER of  
 the NW 1/4 of  
 SECTION 32.

Application No. 15567

Permit No. G-15644

89 acres:  
 LANDS IRRIGATED  
 CERTIFICATE 20401 (PERMIT No. 16827)  
 (APP. No. 21449)



LANDS TO BE IRRIGATED UNDER PERMIT G-15567  
 with THIS APPLICATION.  
 85.09 ACRES.

AREA TO BE IRRIGATED IN  
 TAX LOT 1401:

47.69 acres → 23.845 ac  
 in NW 1/4 SE 1/4;  
 AND 23.845 ac. in  
 SW 1/4 SE 1/4

RECEIVED  
 JUL 25 2001  
 WATER RESOURCES DEPT  
 SALEM, OR

Including: App. No 21449 Permit No. 16827  
 IN NAME OF  
 I. R. Hanson

Surveyed July 8 1963 by H. L. Coffman

AND  
 NEW LANDS.

copied  
 by  
 LC