



MORSE BROS., INC.
 Ready Mix Concrete Well
 5700 NE Sundial Road
 Multnomah County
 Township 1(N), Range 3(E)
 Section 14, Tax Lot 300 (8.14 acres)

Scale: 1" = 200'
 Date: January 10, 2001
 COLUMBIA BASIN

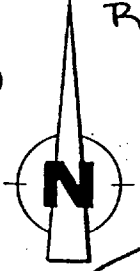

Columbia
 RIVER

NORTH
 TRAN
 NORTH

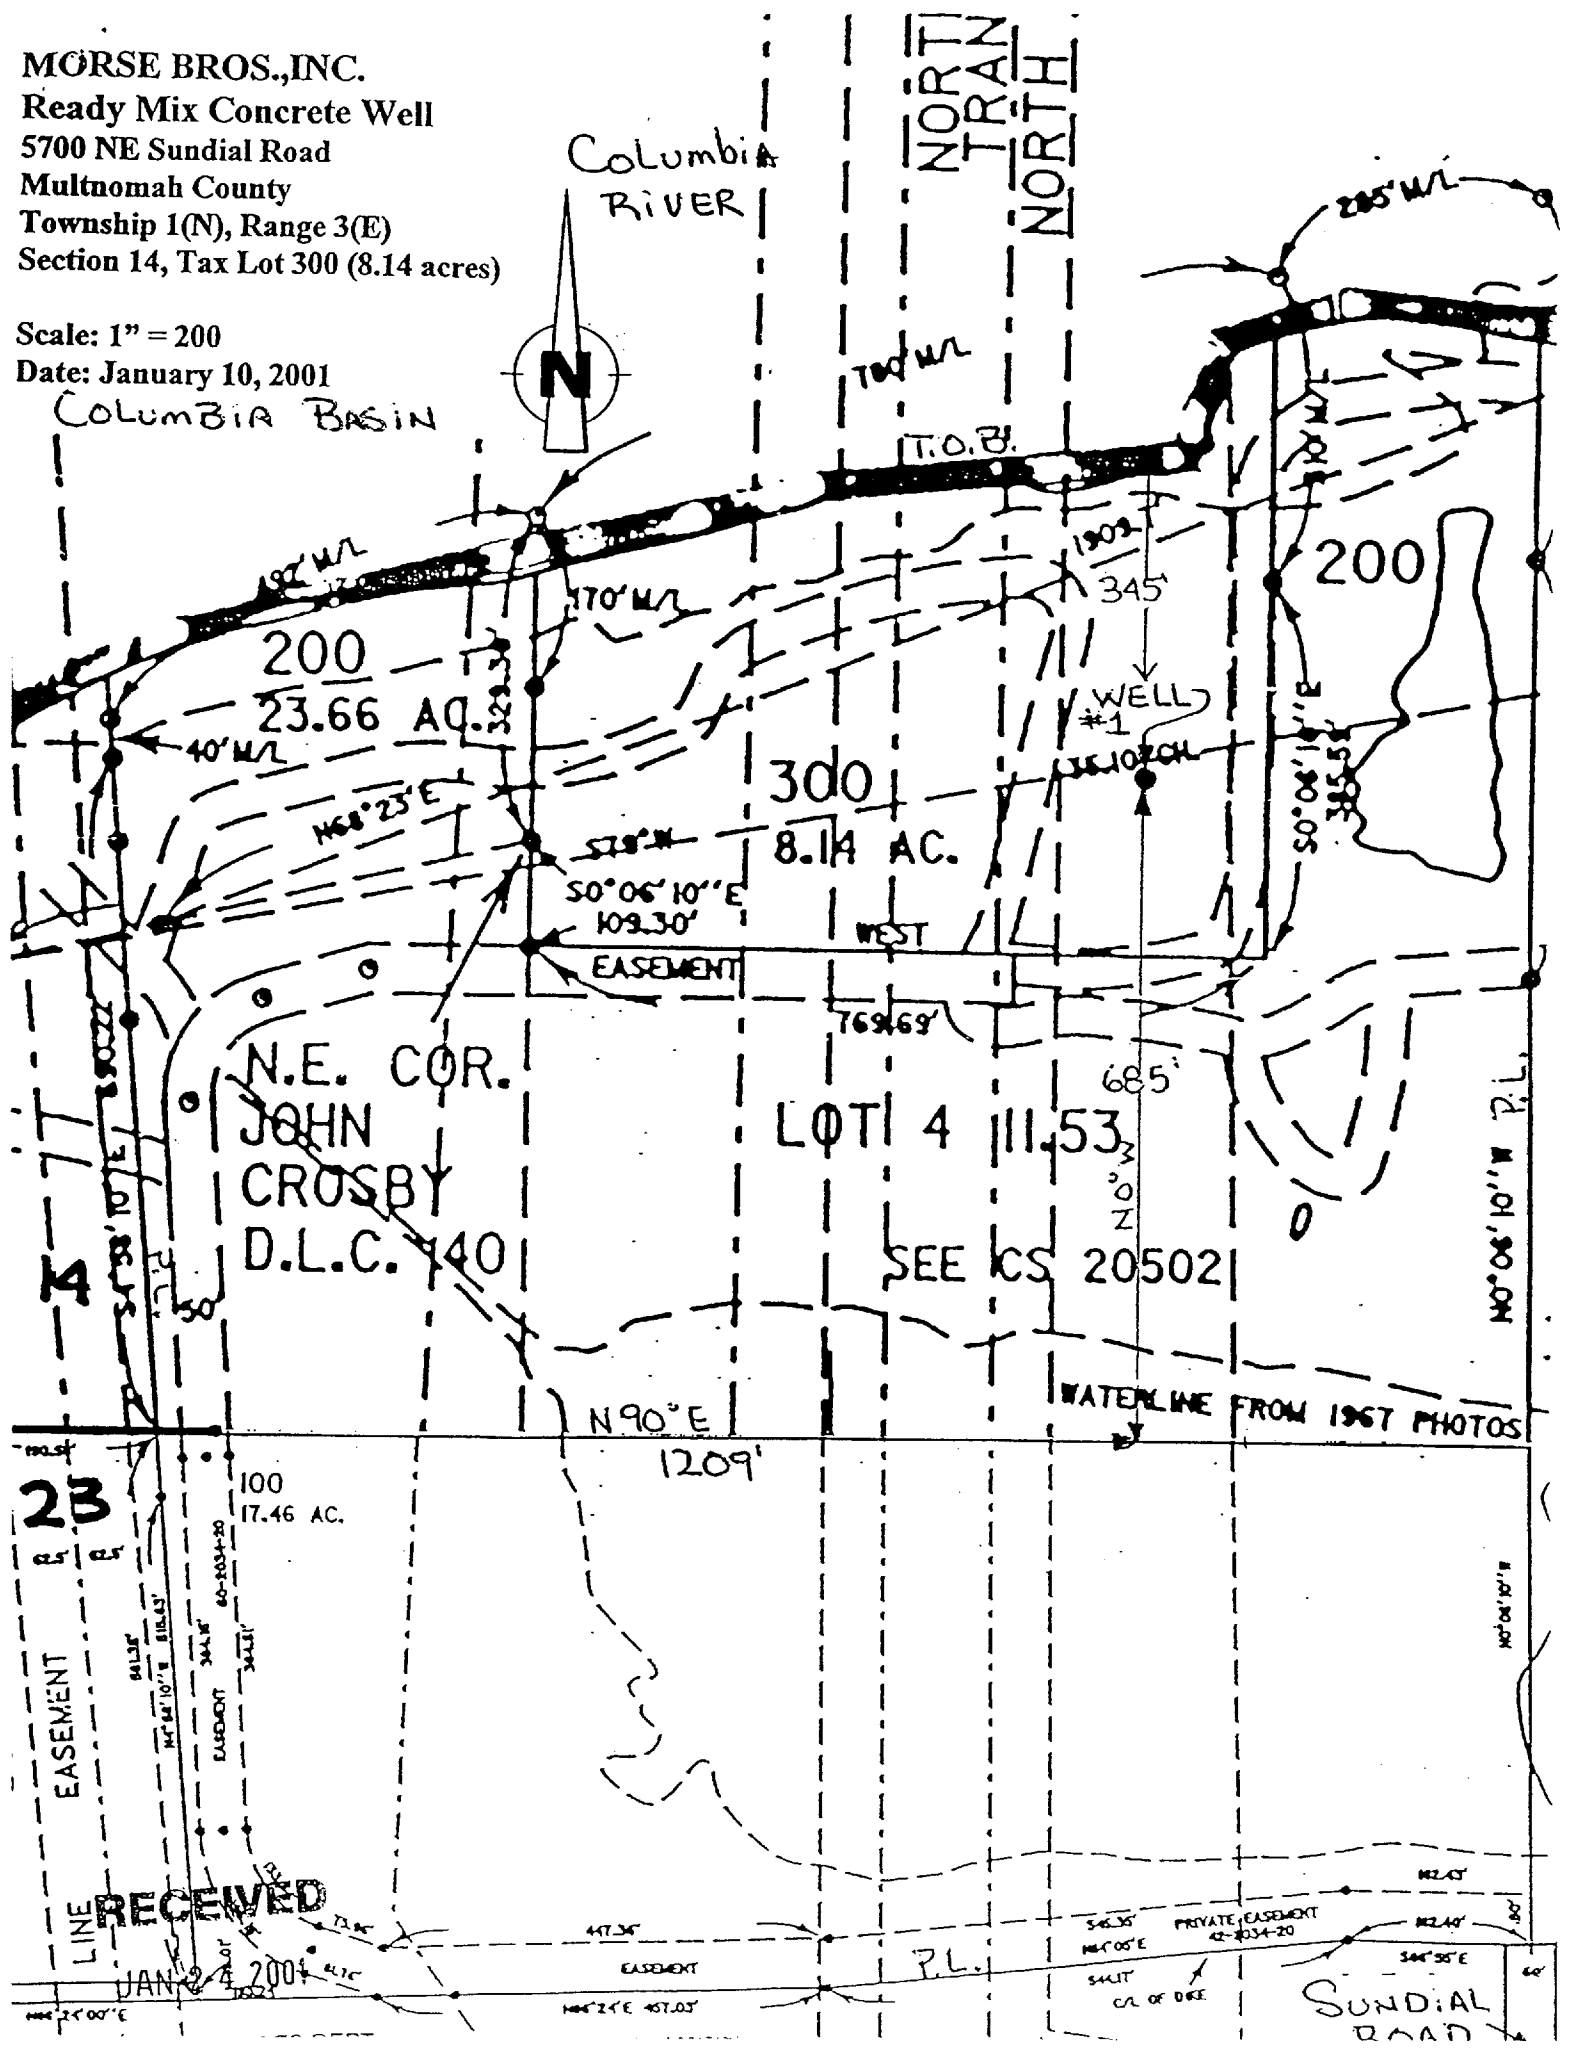

23

N.E. COR.
 JOHN
 CROSBY
 D.L.C. #40

300
 8.14 AC.

200
 23.66 AC.

LOT 4 III.53
 SEE CS 20502

200

RECEIVED

JAN 24 2004

SUNDIAL
 ROAD