


T 1 N, R 13 E, W 1 M

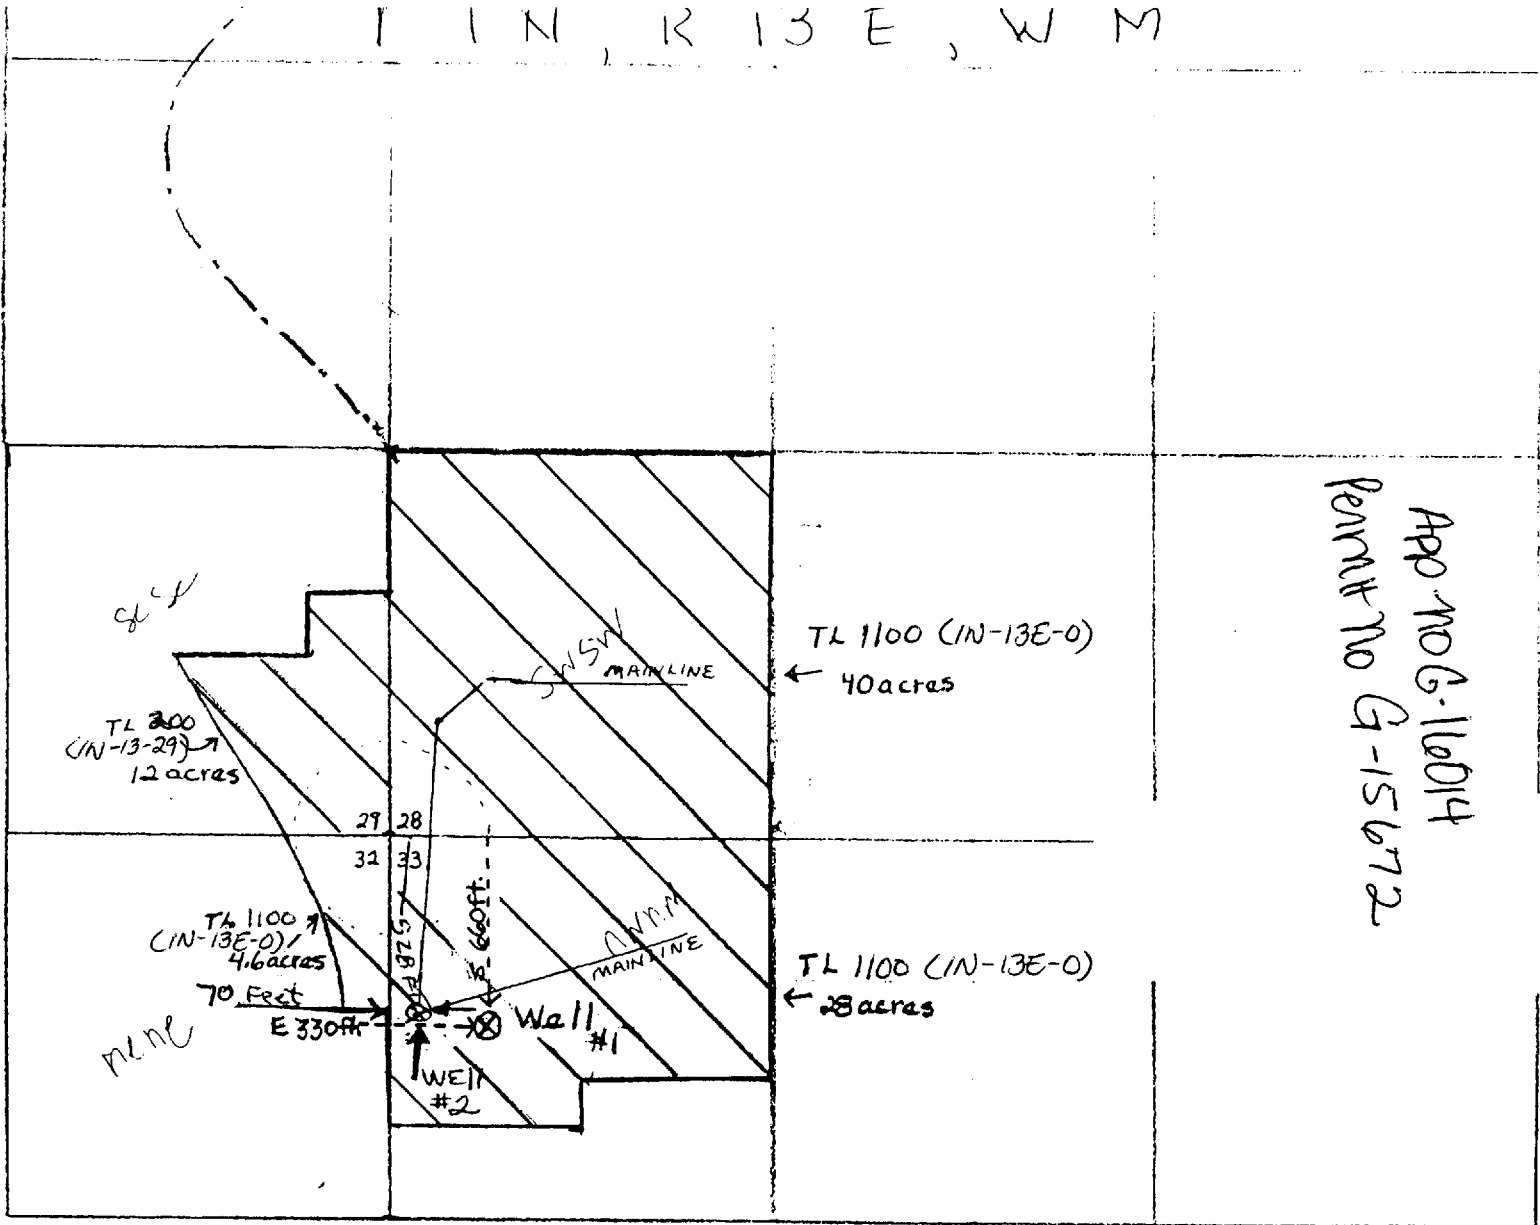

APP NO G-16014  
PERMIT NO G-15672



# MEL OMEG APPLICATION MAP

2" = 1320'

**RECEIVED**  
MAY 21 2003  
WATER RESOURCES DEPT.  
SALEM, OREGON