

GROUND WATER APPLICATION MAP

SECTION 31, T. 17 S., R. 17 E., W.M. SECTION 6, T. 18 S., R. 17 E., W.M. CROOK COUNTY, OREGON

RECEIVED

WAIEH RESOURCES VEPT. SALEM, OREGON


JUN 7 1999

Application No. 6-14999 Permit No. 6-15677

I, ROBERT E. BAXTER, CERTIFIED WATER RIGHT EXAMINER IN THE STATE OF OREGON, HEREBY CERTIFY THAT THIS WATER RIGHT SURVEY MAP WAS PREPARED BY ME.

THE PREPARATION OF THIS MAP IS FOR THE PURPOSE OF IDENTIFYING THE LOCATION OF THE WATER RIGHT ONLY AND HAS NO INTENT TO PROVIDE CHIMENSIONS OF LOCATIONS OF PROPERTY OWNERSHIP LINES.



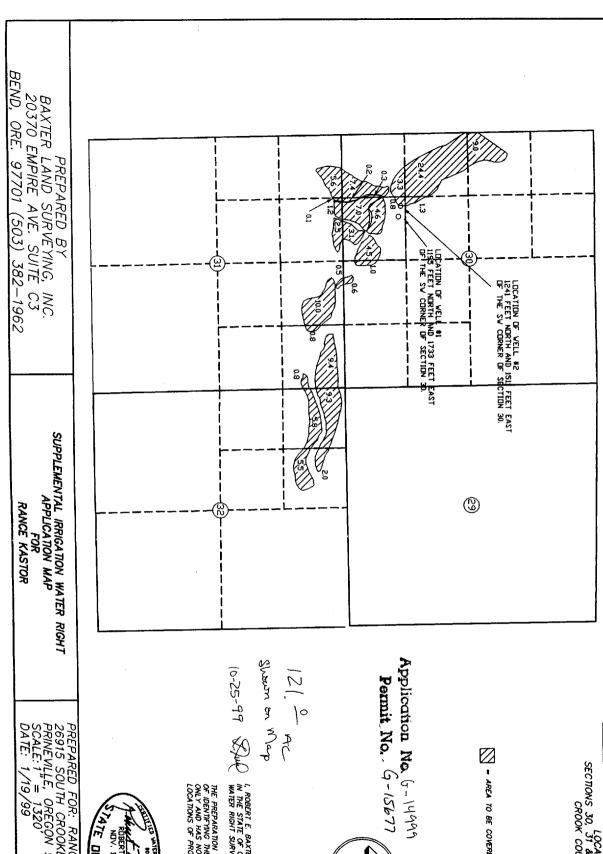

PROPOSED SUPPLEMENTAL IRRIGATION WATER RICHT MAP
LOCATED IN
SECTIONS 30, 31 & 32, T. 17 S., R. 17 E., W.M.
CROOK COUNTY, OREGON

RECEIVED

JUN 7 1999

WATER RESOURCES DEPT. SALEM, OREGON

- AREA TO BE COVERED BY SUPPLEMENTAL IRRIGATION

1, ROBERT E. BAXTER, CERTIFIED WATER RIGHT EXAMINER (0-25-97 WIN THE STATE OF OREGON, HEREBY CERTIFY THAT THIS WATER RIGHT SURVEY MAD WAS PREPARED BY ME.

THE PREPARATION OF THIS MAP IS FOR THE PURPOSE OF IDENTIFYING THE LOCATION OF THE MATER RICHT ONLY AND HAS NO INTENT TO PROVDE DIMENSIONS OR LOCATIONS OF PROPERTY OWNERSHIP LINES.



PREPARED FOR: RANCE KASTOR 26915 SOUTH CROOKED RIVER HIGHWAY PRINEWILLE, OREGON 97754 (541)-576-2825 SCALE: 1 = 1320 DATE: 1/19/99