


1" = 200'

WEST 75 R 1E W 1/4

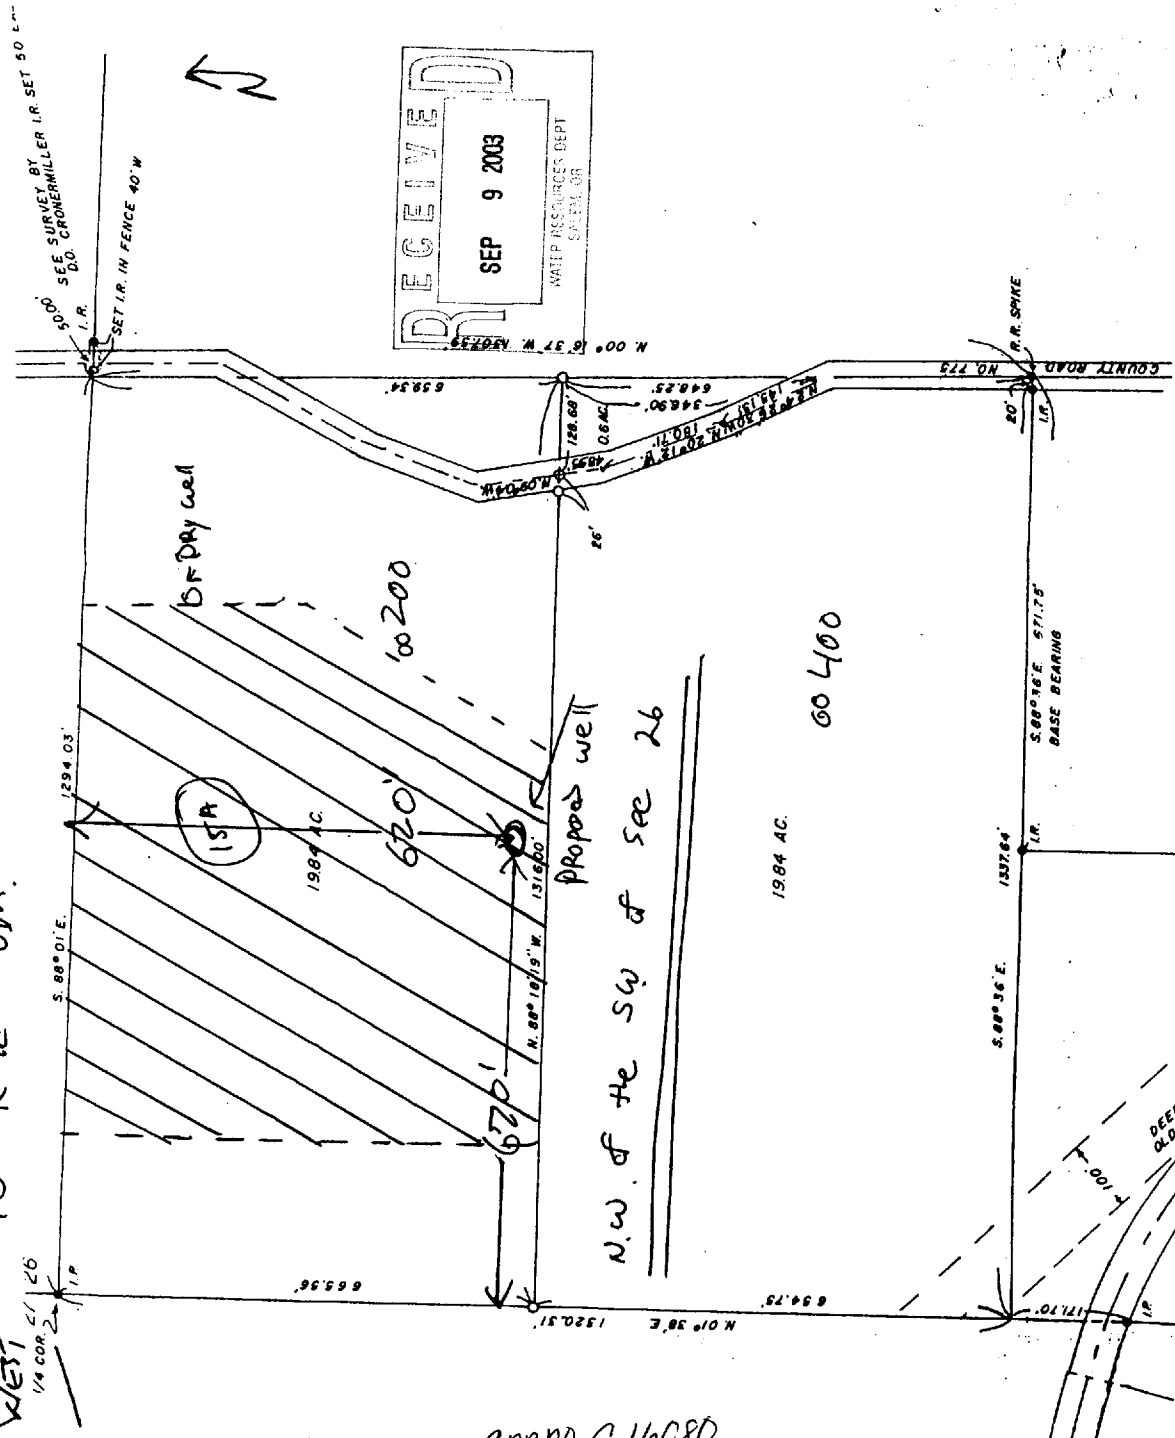

RECEIVED
 SEP 9 2003
 WATER RESOURCES DEPT
 SALEM, OR

app no G-16080