


FOR ASSESSMENT
AND TAXATION
ONLY

SECTION 22 T.16S. R4W. W.M.
LANE COUNTY
SCALE 1" = 400'

DATE	APPROVED BY	DATE
11/17/03	W. J. JUDKINS	11/17/03

16 04 22 00
C.A.D. SYS.

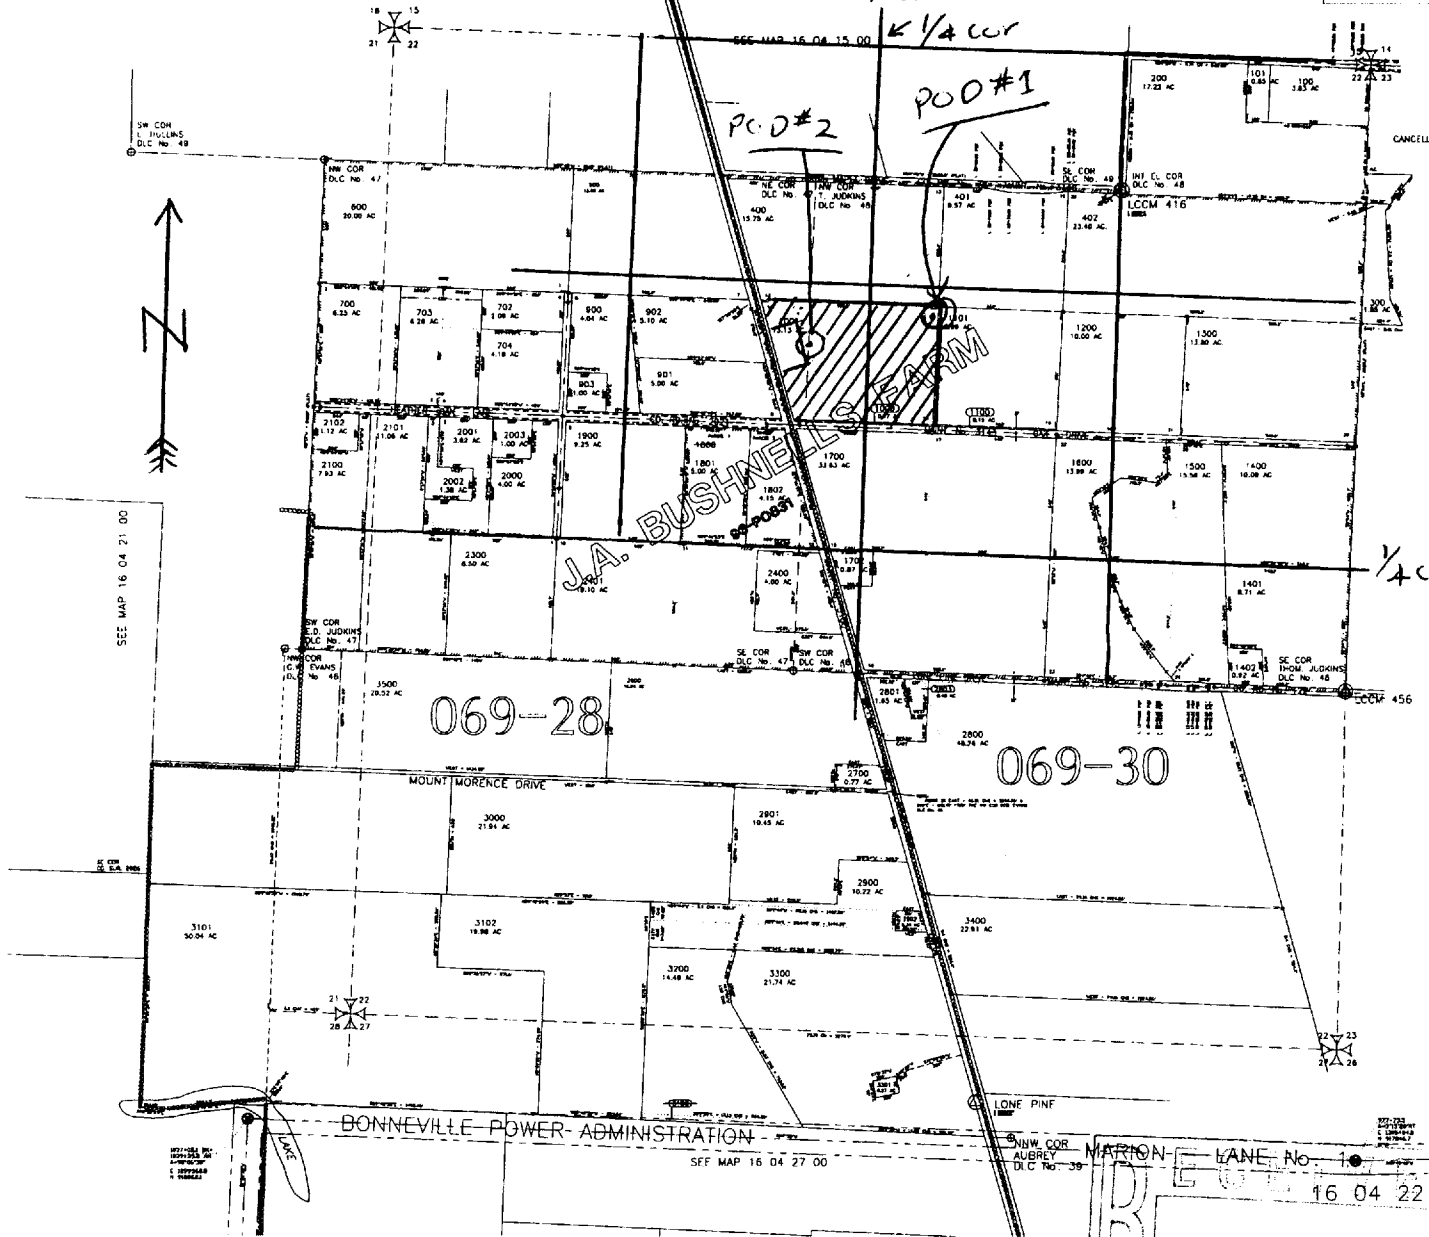

RECEIVED
16 04 22 00
SEP 30 2003
WATER RESOURCES DEPT
SALEM, OR

T 16 S R 4 W Sec 22

Tax Lot 1001

Preferred site → POD #1 is 1400 ft S and 2,230 ft W of NE cor Sec 22

POD #2 is 1,575 ft S and 2,875 ft W of NE cor Sec 22

SW NE 5.5 acres

SE NW 6.5 acres

App 6-16106