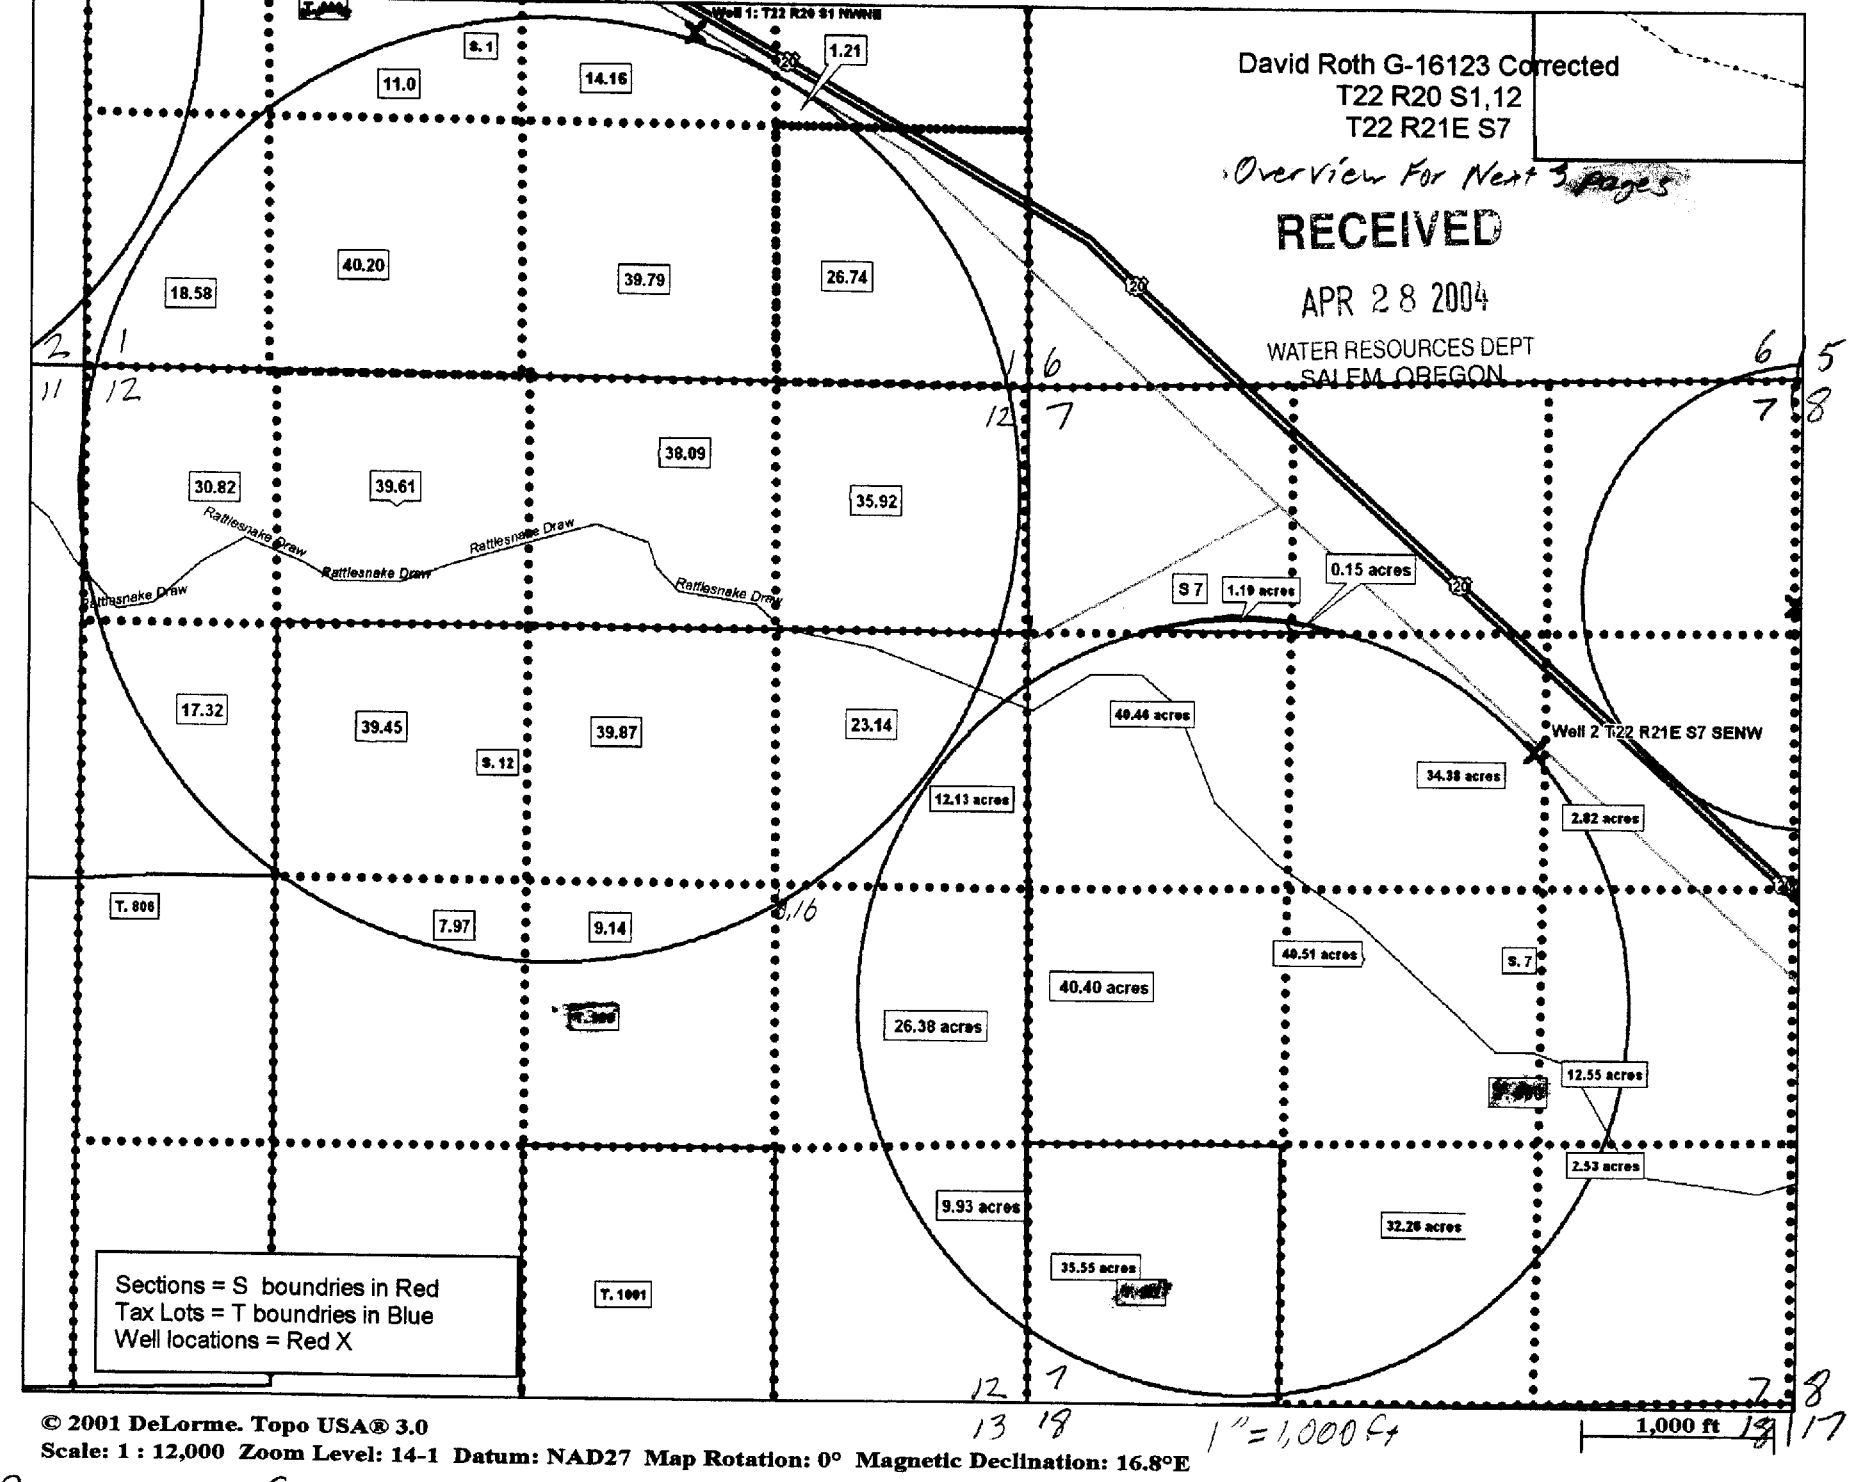

© 2001 DeLorme. Topo USA® 3.0

Scale: 1 : 12,000 Zoom Level: 14-1 Datum: NAD27 Map Rotation: 0° Magnetic Declination: 16.8°E

1" = 1,000 Ft

Permit no G-15706