


WELL #1 LOCATED FROM COMMON SECTIONS 16, 17, 20, 21 2550 FT SOUTH 480 FT EAST 17

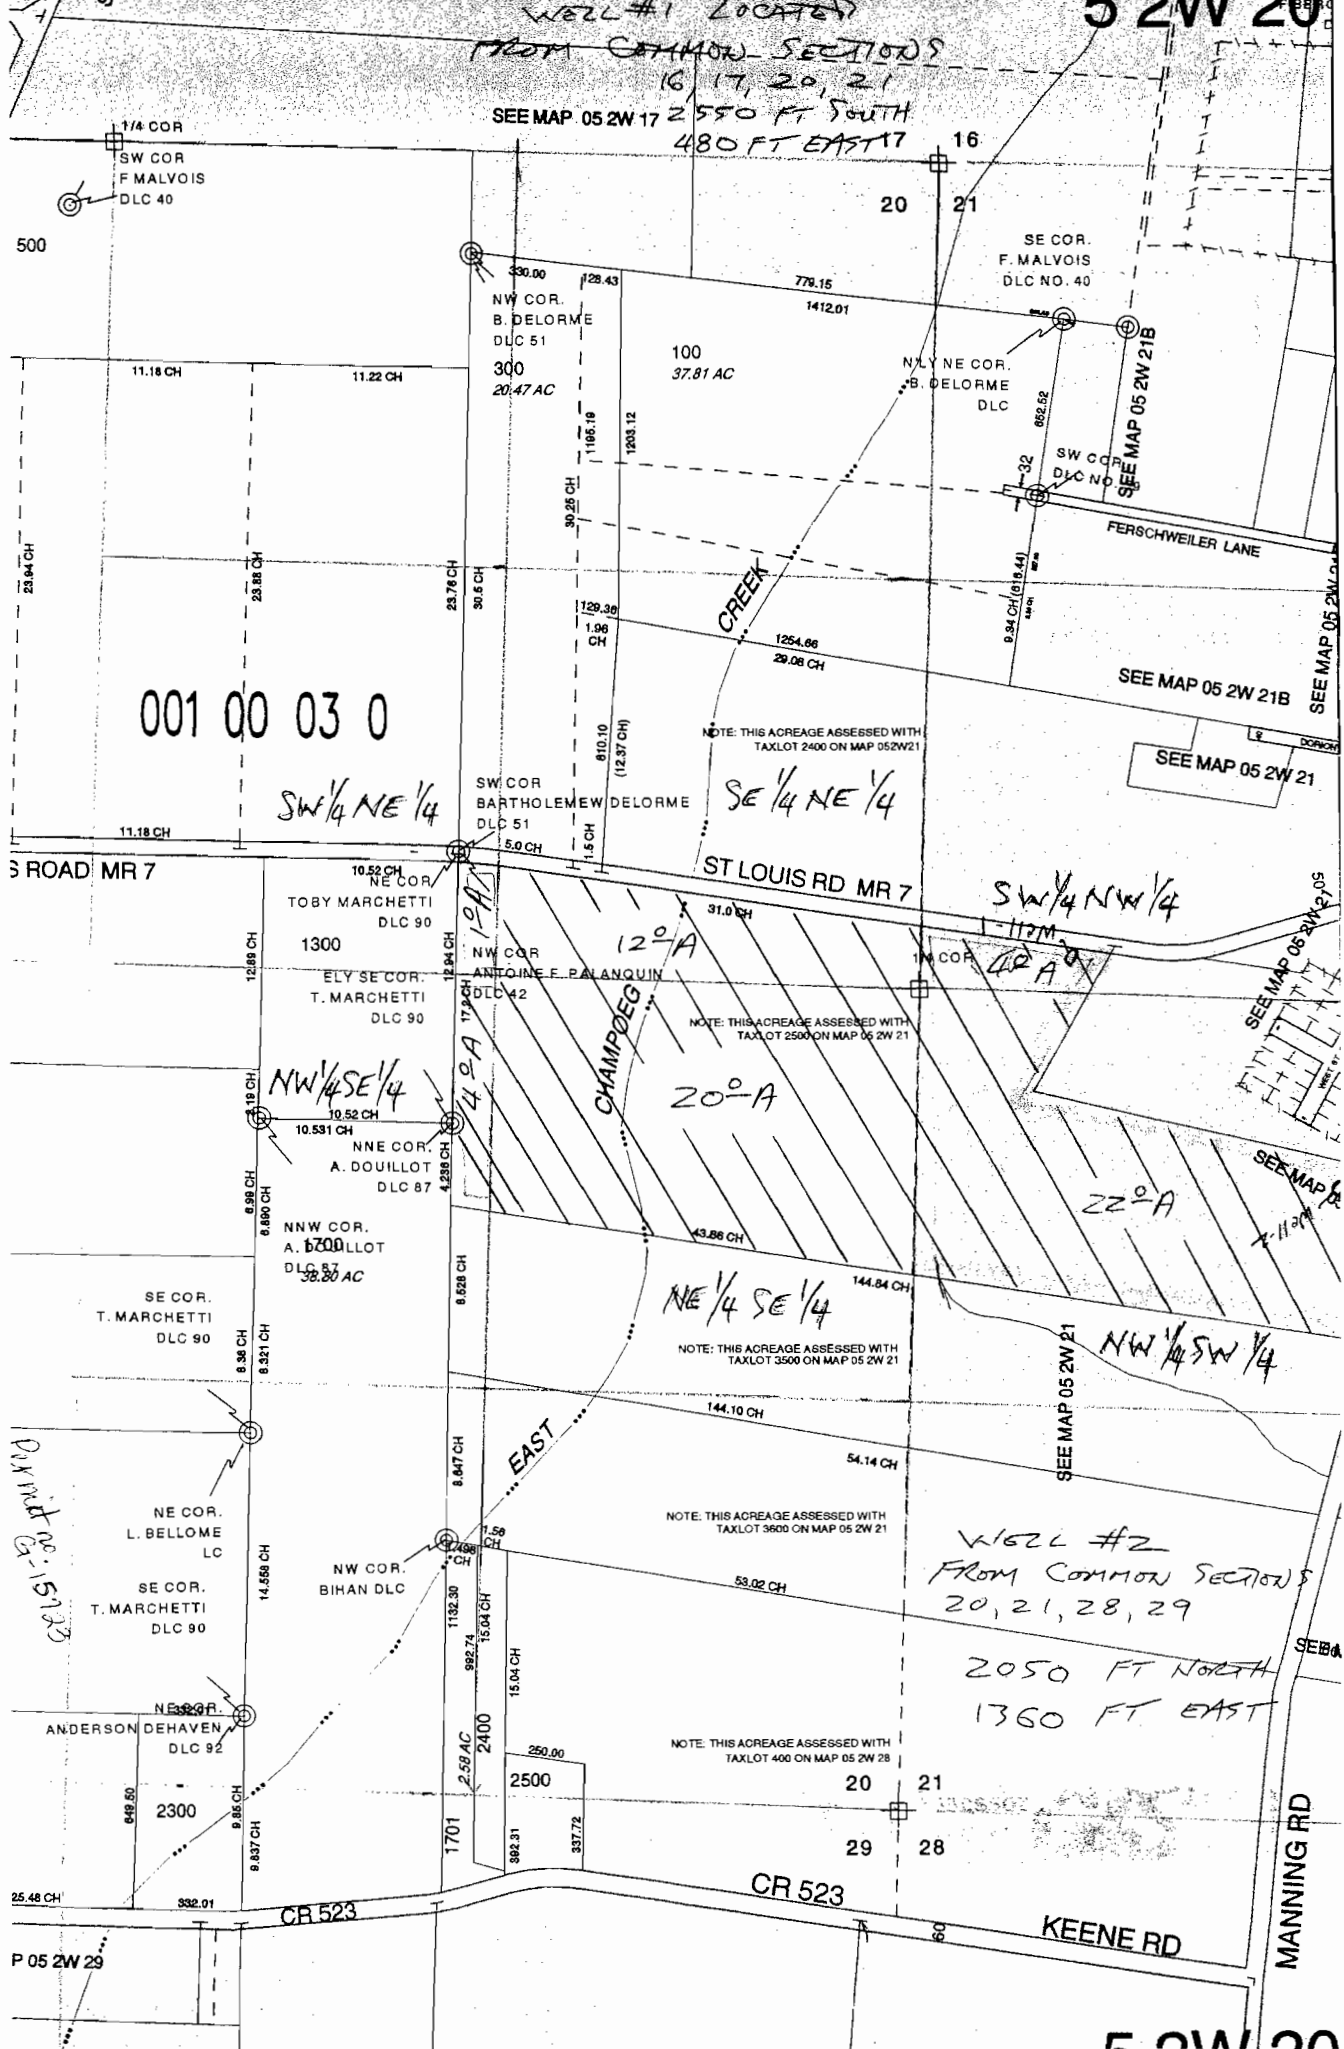

001 00 03 0

SW 1/4 NE 1/4

SE 1/4 NE 1/4

SW 1/4 NW 1/4

NW 1/4 SE 1/4

NE 1/4 SE 1/4

NW 1/4 SW 1/4


WELL #2 FROM COMMON SECTIONS 20, 21, 28, 29 2050 FT NORTH 1360 FT EAST