


T. 6 S., R. 4 W. W.M.

RECEIVED

MAR 27 1995

WATER RESOURCES DEPT.
SALEM, OREGON

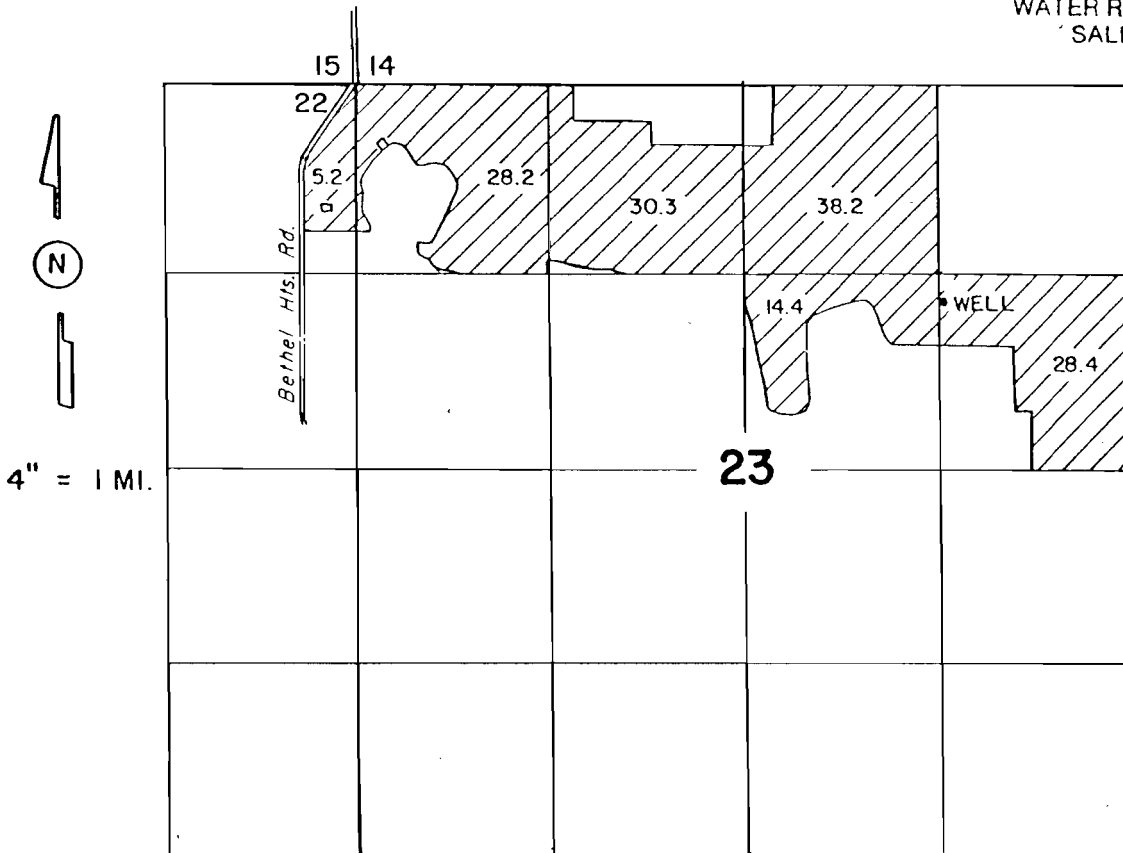


Application No. G-13820
Permit No. G12037

WATER RIGHT MAP FOR
LIN SHEN KOO dba
TEMPERANCE HILL VINEYARD

SURVEYED ON March 1, 1995

THIS MAP WAS PREPARED FOR THE PURPOSE OF IDENTIFYING THE LOCATION OF A WATER RIGHT ONLY AND IS NOT INTENDED TO PROVIDE LEGAL DIMENSIONS OR LOCATION OF PROPERTY OWNERSHIP LINES.

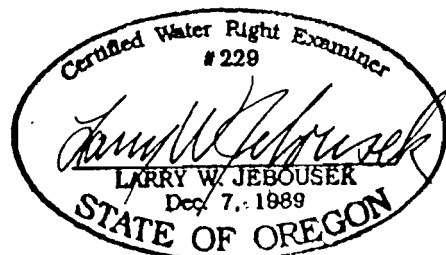

WELL LOCATED 178' S. & 15' E. FROM S.W. COR. OF NE 1/4, NE 1/4 SEC. 23