



APPLICATION MAP

In the name of Tom DeArmond

Sections 32 & 33 T4S R 1 W, WM

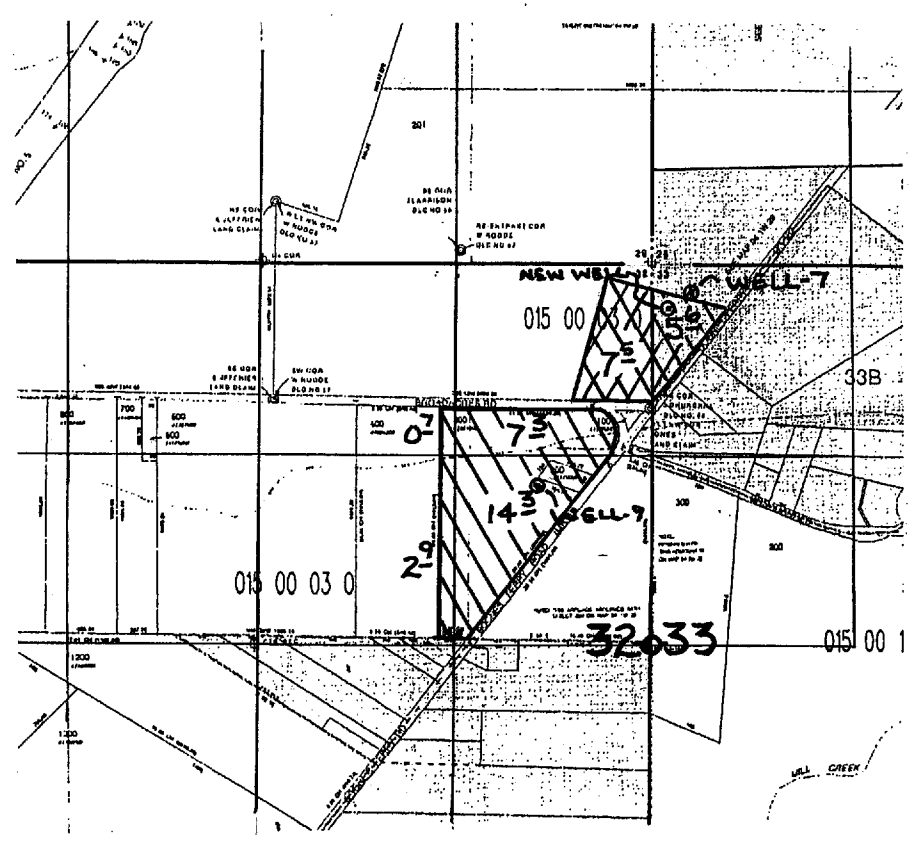

irrigation and nursery use

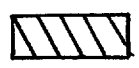

nursery use

Well # 7: 770' N and 250' E from the NE corner DLC 56
Well # 9: 540' S and 860' W from the NE corner DLC 56
New Well: 680' N and 100' E from the NE corner DLC 56

Scale 1" = 1320'

*App No
E-13990
Permit No*