

WORK COPY

RECEIVED
MAR 15 2004
WATER RESOURCES DEPT
SALEM, OREGON


T-17s R-44e

SCALE 1" = 1000'

RECEIVED

DEC 27 2004

WATER RESOURCES DEPT
SALEM, OREGON

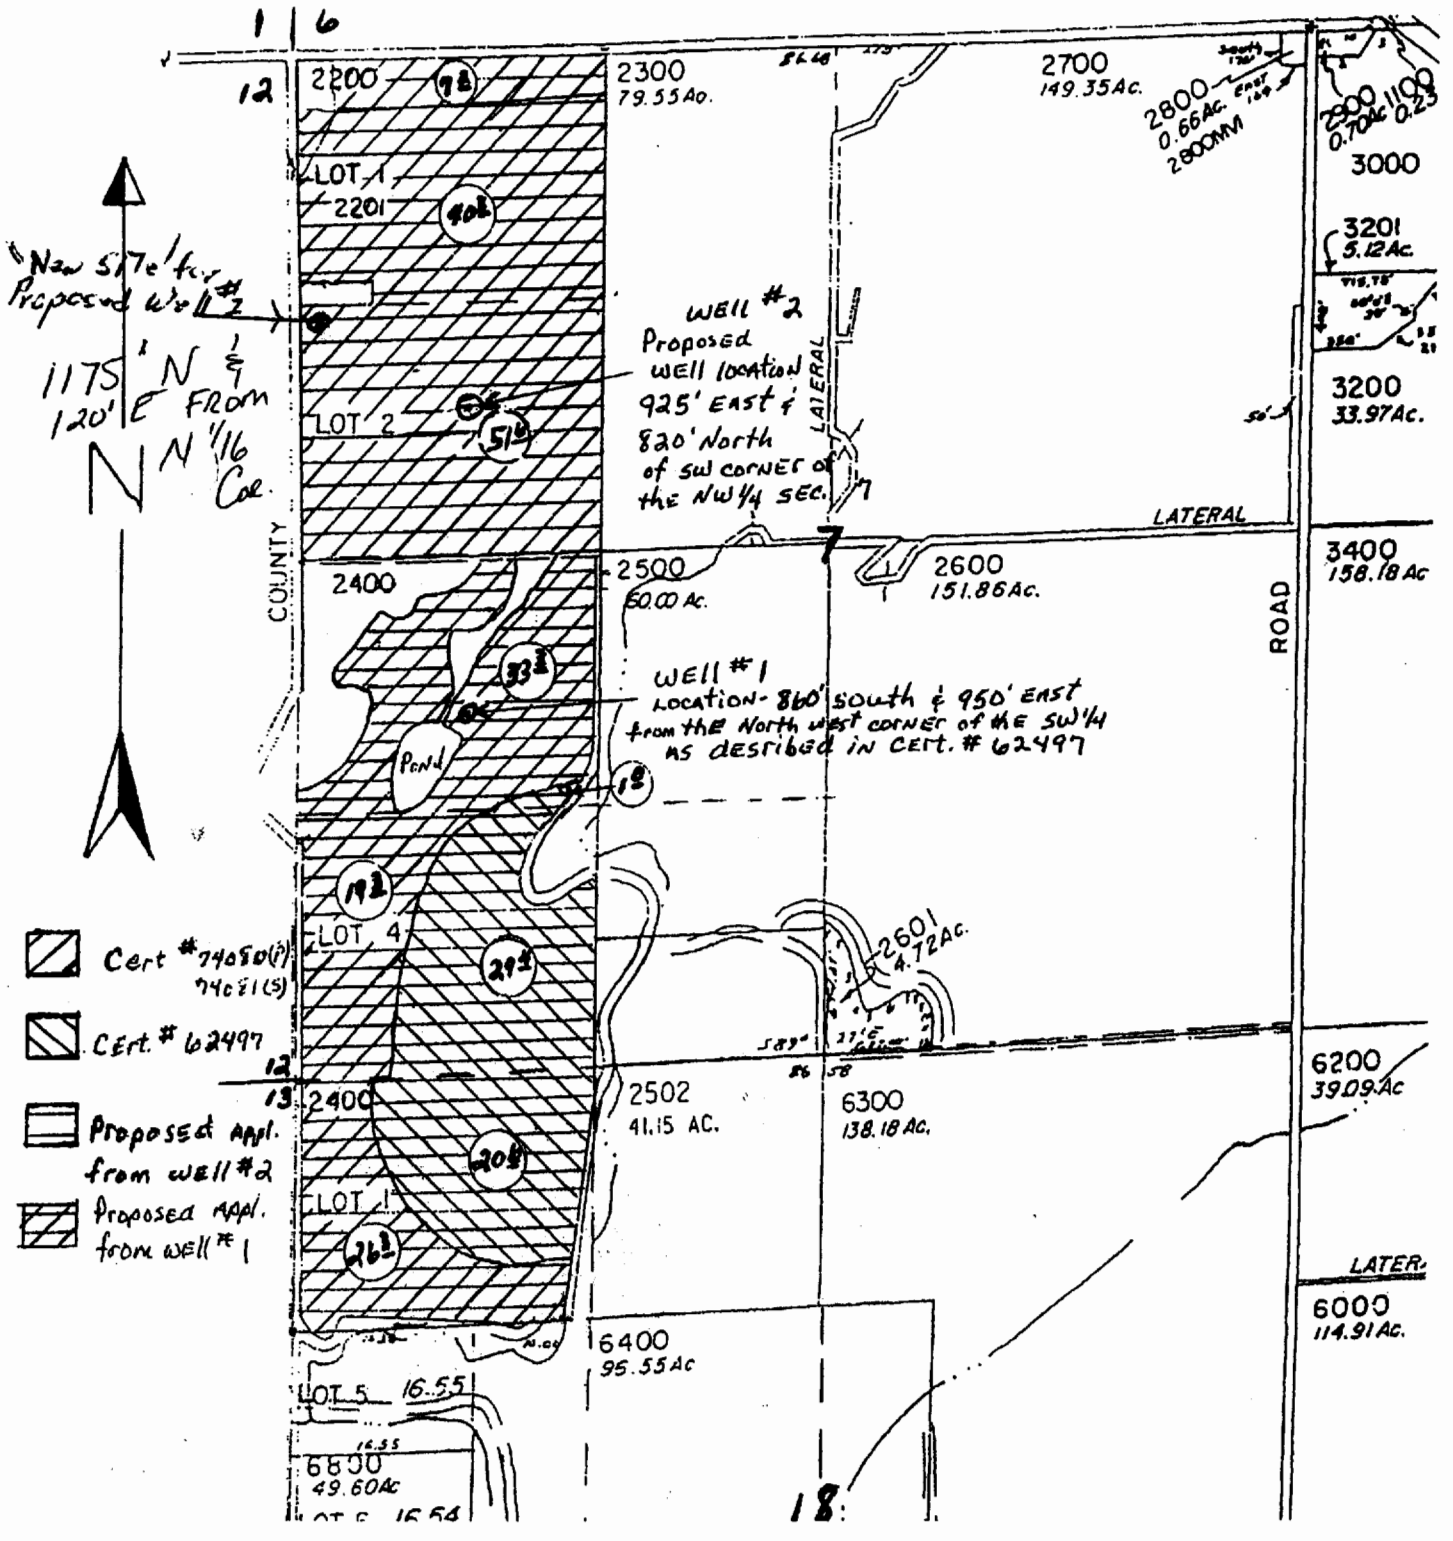

My Water Rights Applic. # is G-16215

To: Ore. Water Resources Dept.

AT This Time I am ready to proceed with the drilling of my well, but would like to amend the proposed location of Well #2 to a 'new' location to be drilled 1175' ~~ft~~ straight North of the S.W. corner of the N.W. 1/4 Sec. 7.

This is the recommended location of the well driller.

Thank you,
JR Higgins

P.S. Also submitted is my check #3724 for the recording fees of \$250.00

RECEIVED
DEC 27 2004
WATER RESOURCES DEPT
SALEM, OREGON