

RECEIVED


APR 08 2003

WATER RESOURCES DEPT.  
SALEM, OREGON

RECEIVED

JUL 15 2003

WATER RESOURCES DEPT.  
SALEM, OREGON

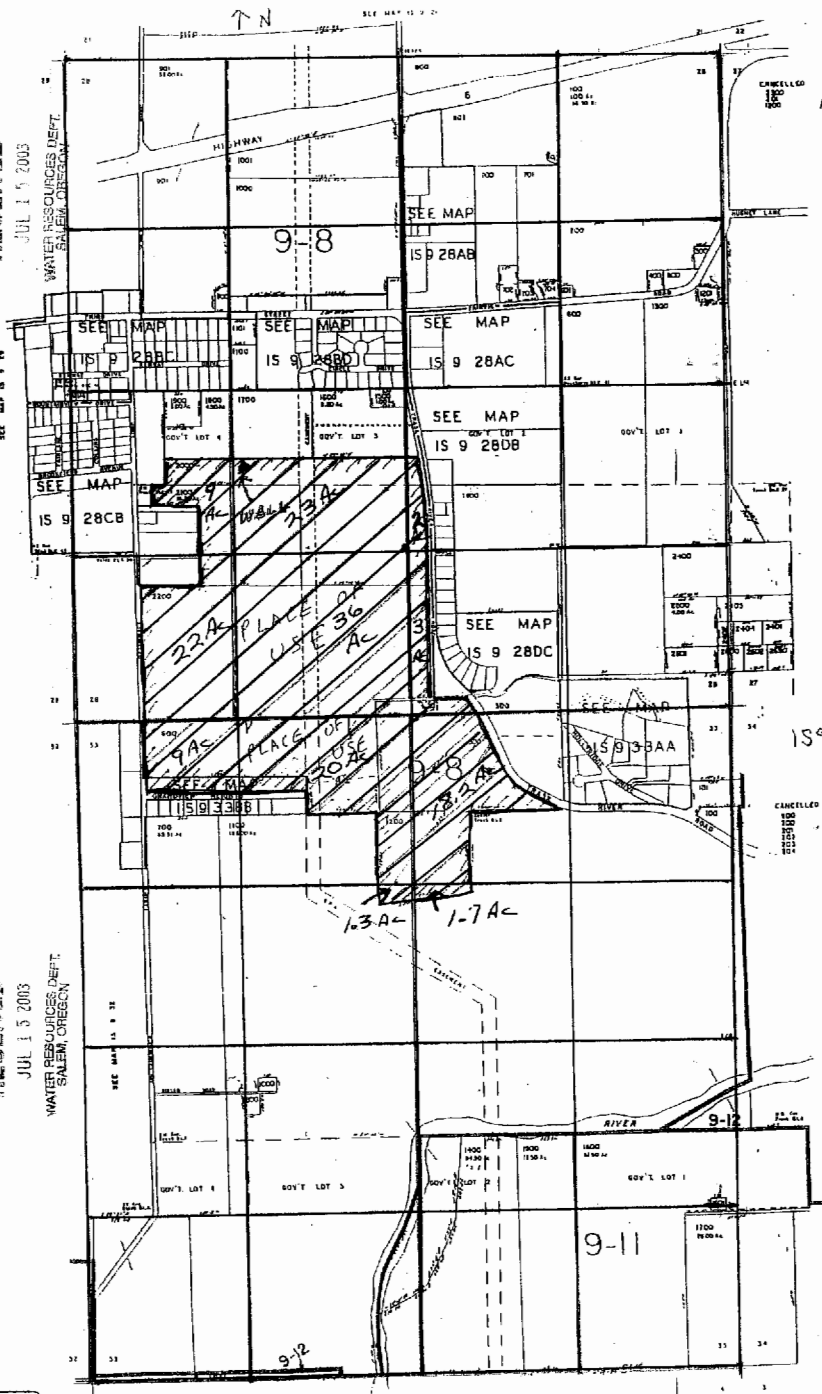

15928

15933

RECEIVED

JUL 15 2003

WATER RESOURCES DEPT.  
SALEM, OREGON

RECEIVED  
AUG 08 2001

SEE MAP 83 7 7