


# WORK COPY

PROPOSED WELL LOCATED  
FROM CENTER SECTION 8  
1400 FEET SOUTH  
500 FEET EAST

TOTAL ACRES  
38.78 A.

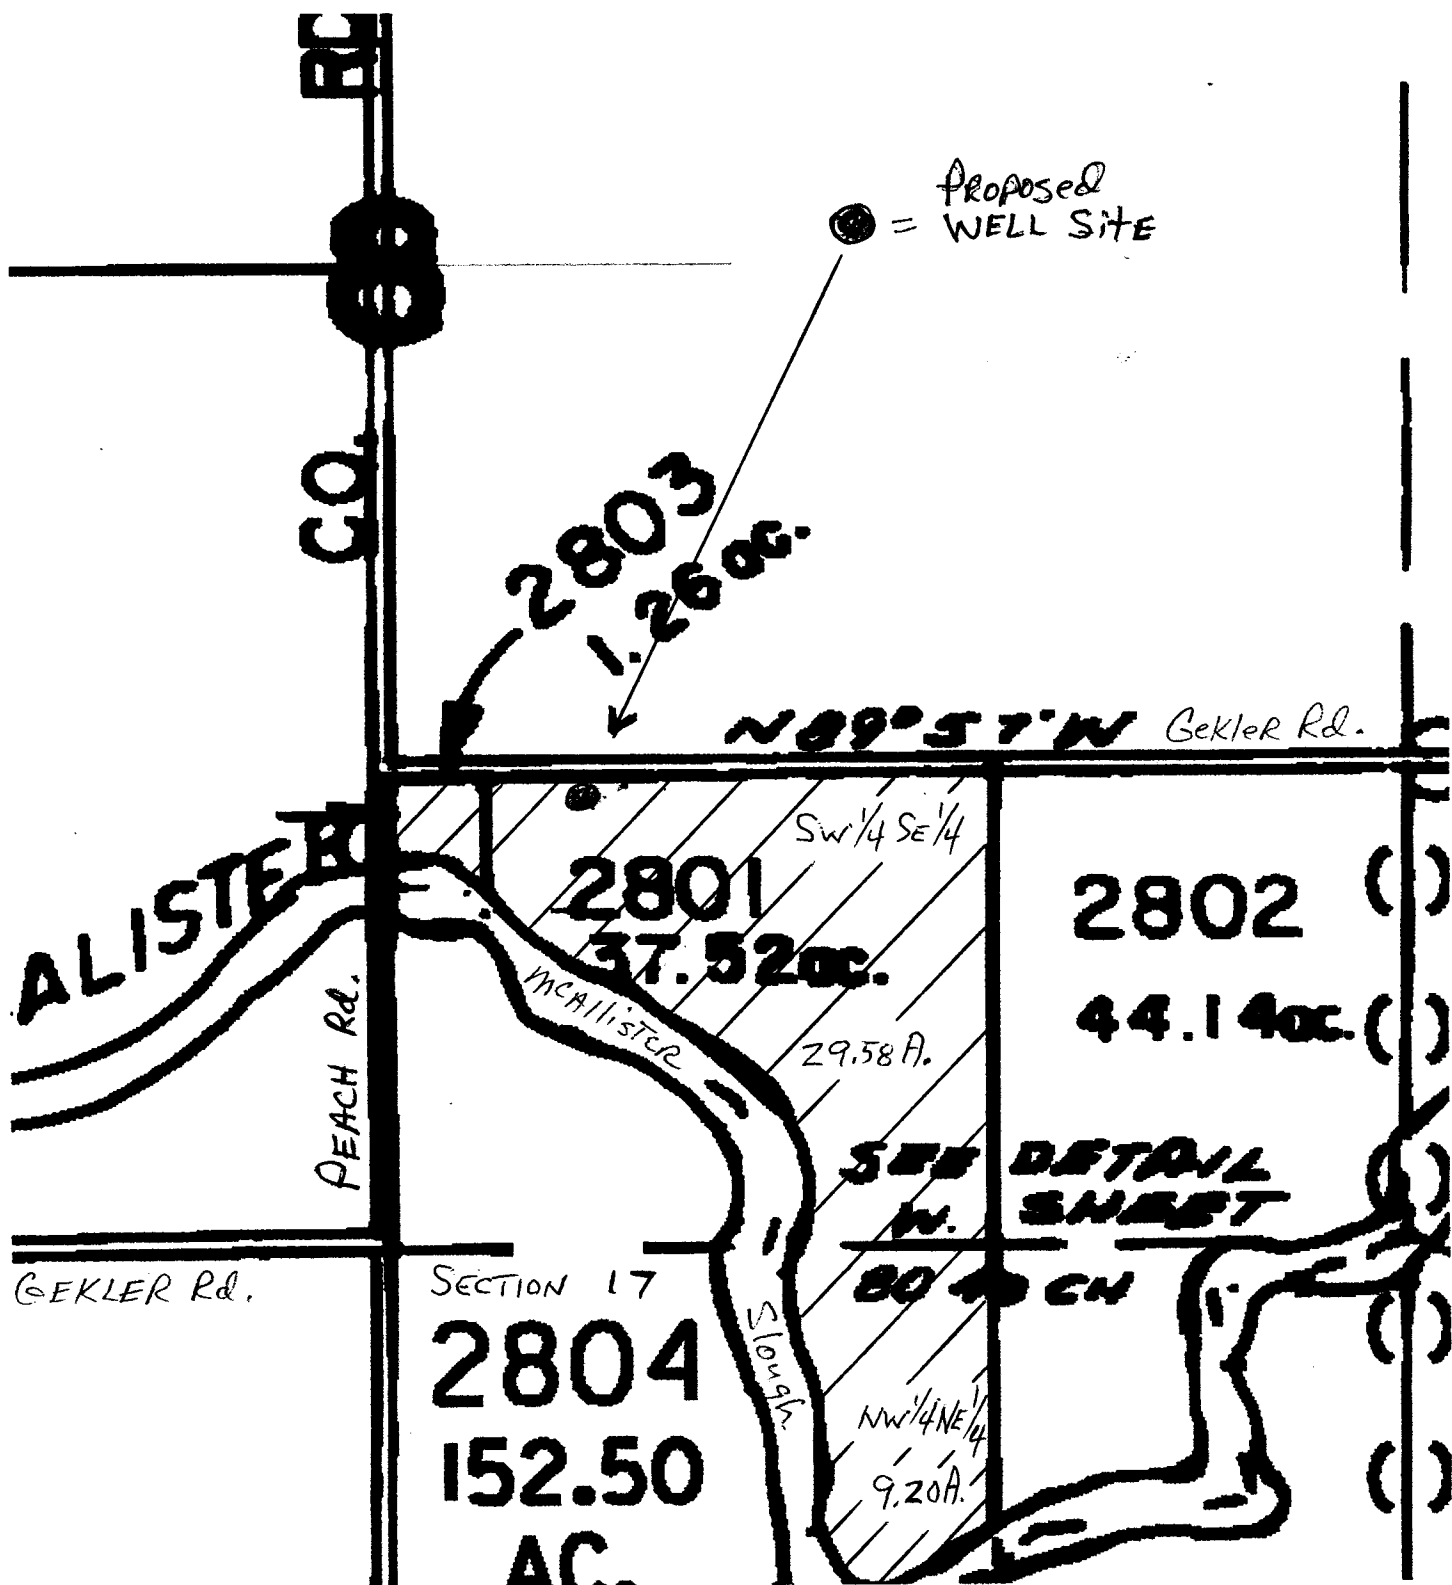

Scale 1" = 500'

SW 1/2, SE 1/4, SEC. 8, Township 3S, Range 39 East



app no. G 16252