

LINE TYPES

- TAX LOT BOUNDARY      OLD PROPERTY LINE
- ROAD RIGHT-OF-WAY      VACATED RIGHT-OF-WAY
- RAILROAD      RAILROAD RIGHT-OF-WAY
- STREAM, LAKE, ETC.      STREAM, LAKE, ETC.
- TAX LOT BOUNDARY      NON-BOUNDARY
- SUBDIVISION BOUNDARY      PARTITION FLAT BND.
- TAX CODE BOUNDARY      EASEMENT

SYMBOL TYPES


- DLC
- CONTROL POINTS
- SURVEY MONUMENTS
- G.L.O. CORNERS
- SECTION
- 1/4 SEC
- 1/16 SEC
- 1/4 COR
- 1/8 COR

NUMBERS

TAX CODE NO.  
000 00 00 0

ACREAGE - ALL ACREAGES EXCLUDE ANY PORTION THAT MAY LIE WITHIN THE INDICATED PUBLIC RIGHT OF WAYS.

TICK MARKS - WHEN A TICK MARK IS INDICATED ON THE EXTENSION OF A LINE FROM THE DIMENSION GOES TO THE TICK MARK GENERALLY THIS IS USED WHEN DIMENSIONS GO INTO PUBLIC RIGHT OF WAYS.

 


ARROWS ARE USED WITH DIMENSIONS IN AREAS OF GREATER COMPLEXITY.

NOTICE: This map was created for Assessor's Office use ONLY.



SCALE 1" = 400'  
or 1:4800

of file created: January 26, 2001

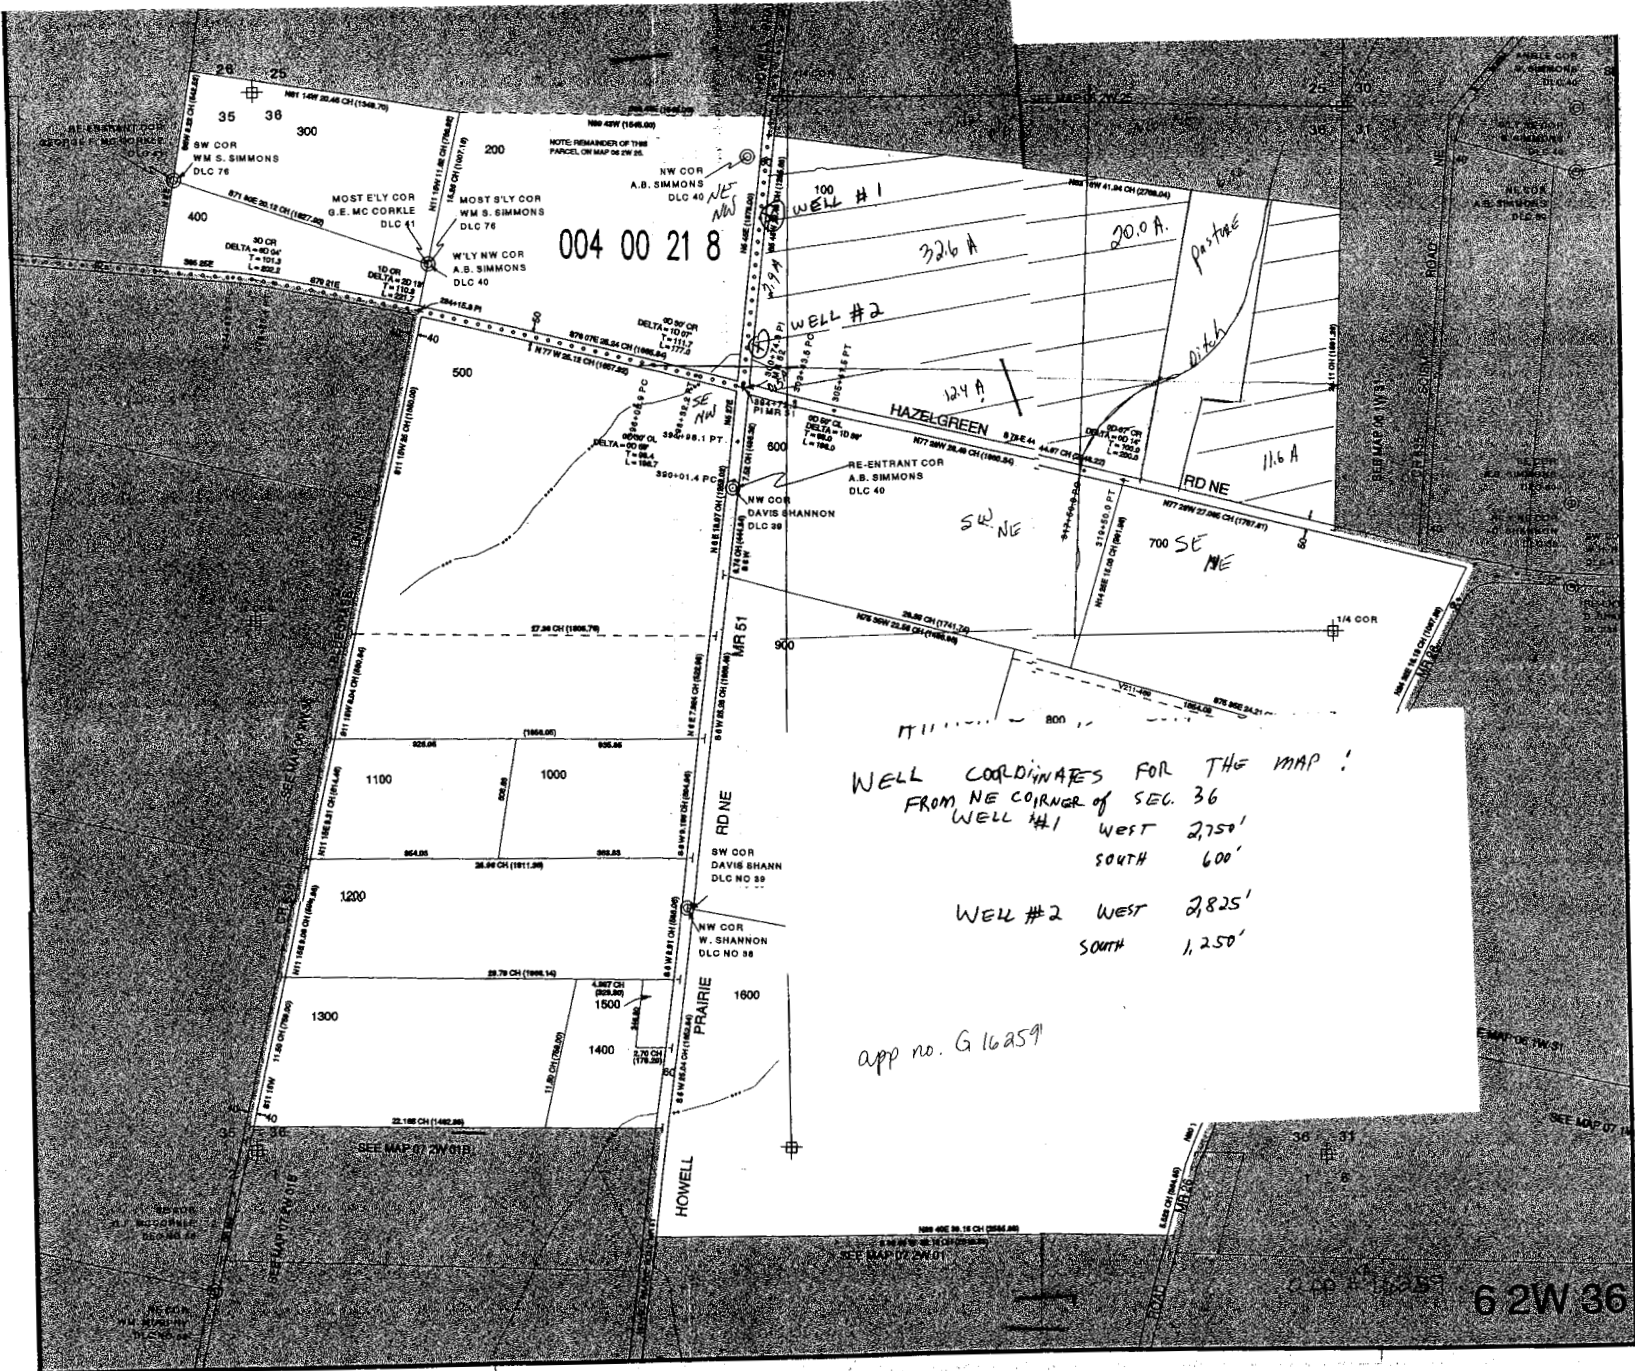

WELL COORDINATES FOR THE MAP!  
FROM NE CORNER OF SEC. 36  
WELL #1      WEST 2750'  
                 SOUTH 600'  
WELL #2      WEST 2825'  
                 SOUTH 1,250'

app no. G 16259

62W 36