


SEC.04 T5S R1W WM, MARION COUNTY

WORK COPY  
APPROX SCALE  
1" = 400 FT

PROPERTY LINE  
RIGHT-OF-WAY  
LAKE, ETC. BOUNDARY  
ON PLAT BDY.  
ENTRANT PERSON ON LINE  
1/16 SEC  
L/M COR  
MOST SOUTHERLY  
PUBLIC

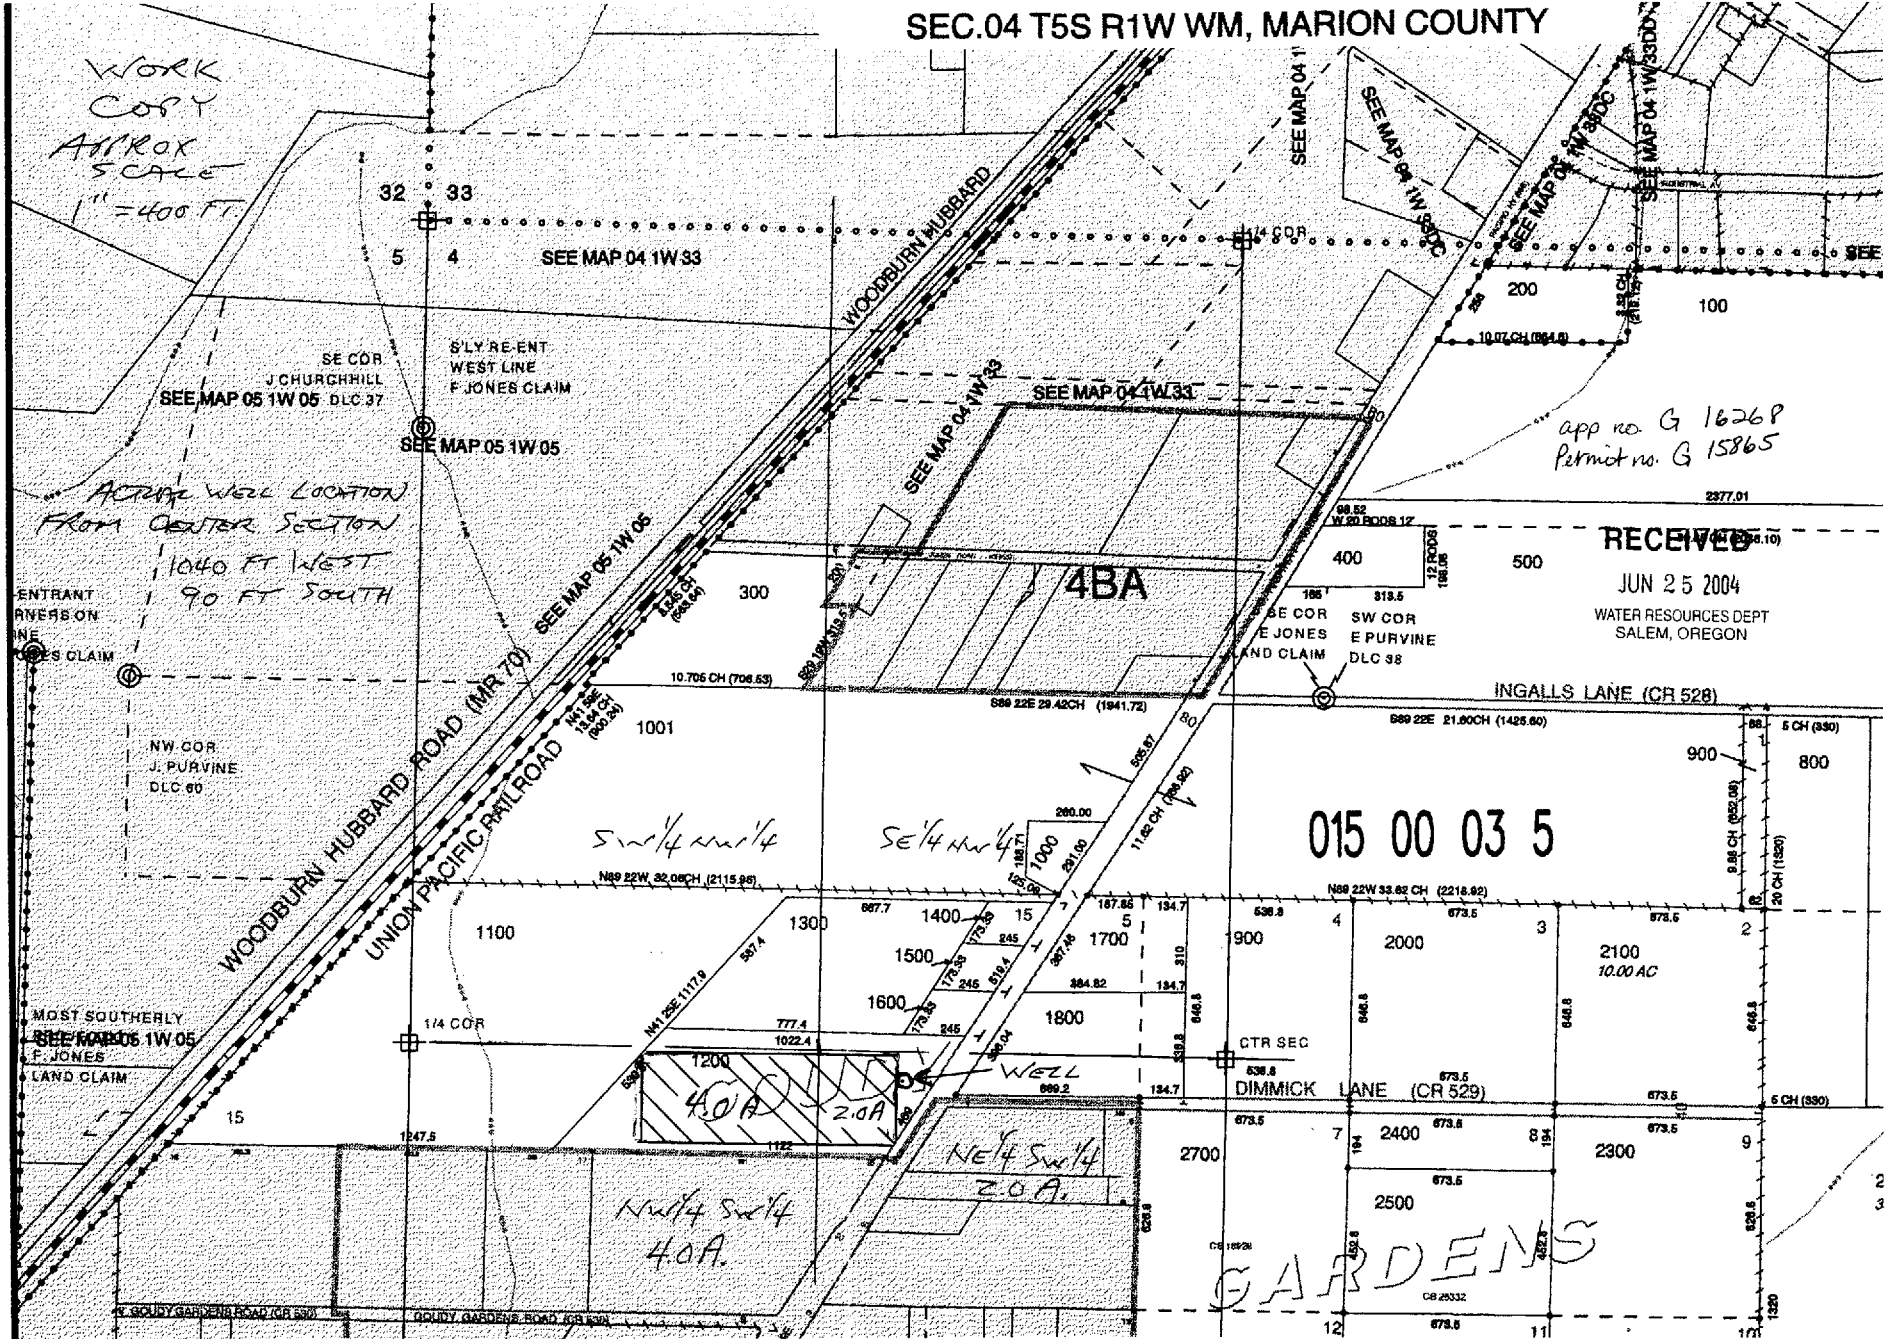

app no. G 1626 P  
Permit no. G 15865

RECEIVED  
JUN 25 2004  
WATER RESOURCES DEPT  
SALEM, OREGON

015 00 03 5

GARDENS