


APR 24 2003

## APPLICATION MAP

## Sections 32 & 33 T4S R 1 W, WM

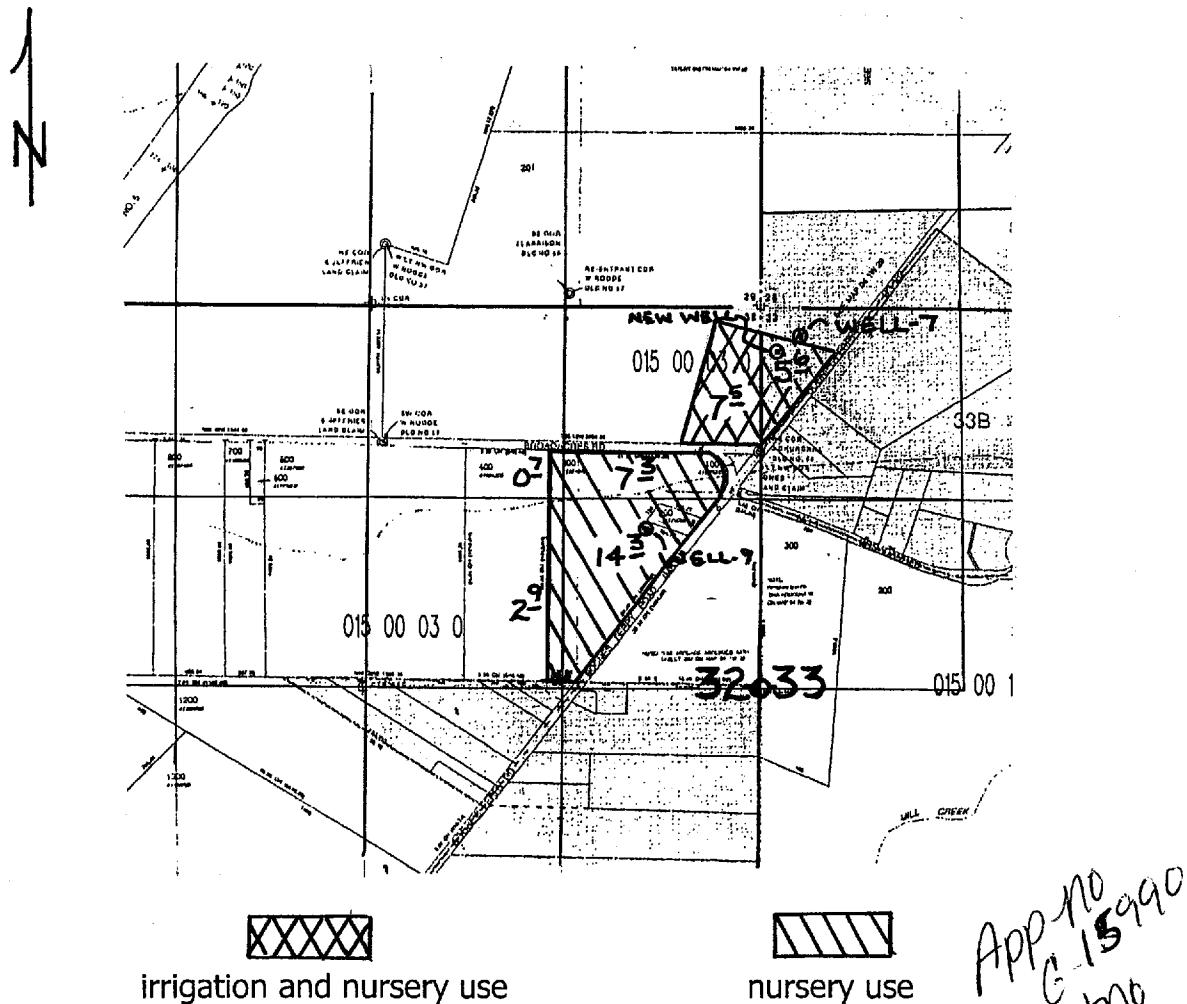

Well # 7: 770' N and 250' E from the NE corner DLC 56  
Well # 9: 540' S and 860' W from the NE corner DLC 56  
New Well: 680' N and 100' E from the NE corner DLC 56

Scale 1" = 1320'