

Work copy



Well 15
1300 ft north
1375 ft west
from se corner
section 15


G-16177

T-19S. R-46E

Scale 1" = 1000'

RECEIVED
FEB 12 2004
WATER RESOURCES DEPT
SALEM, OREGON

-  Primary Appl. # 5-71431 | Suppl. - New Appl.
-  Primary - Cert. # 75691 | Suppl. - New Appl.

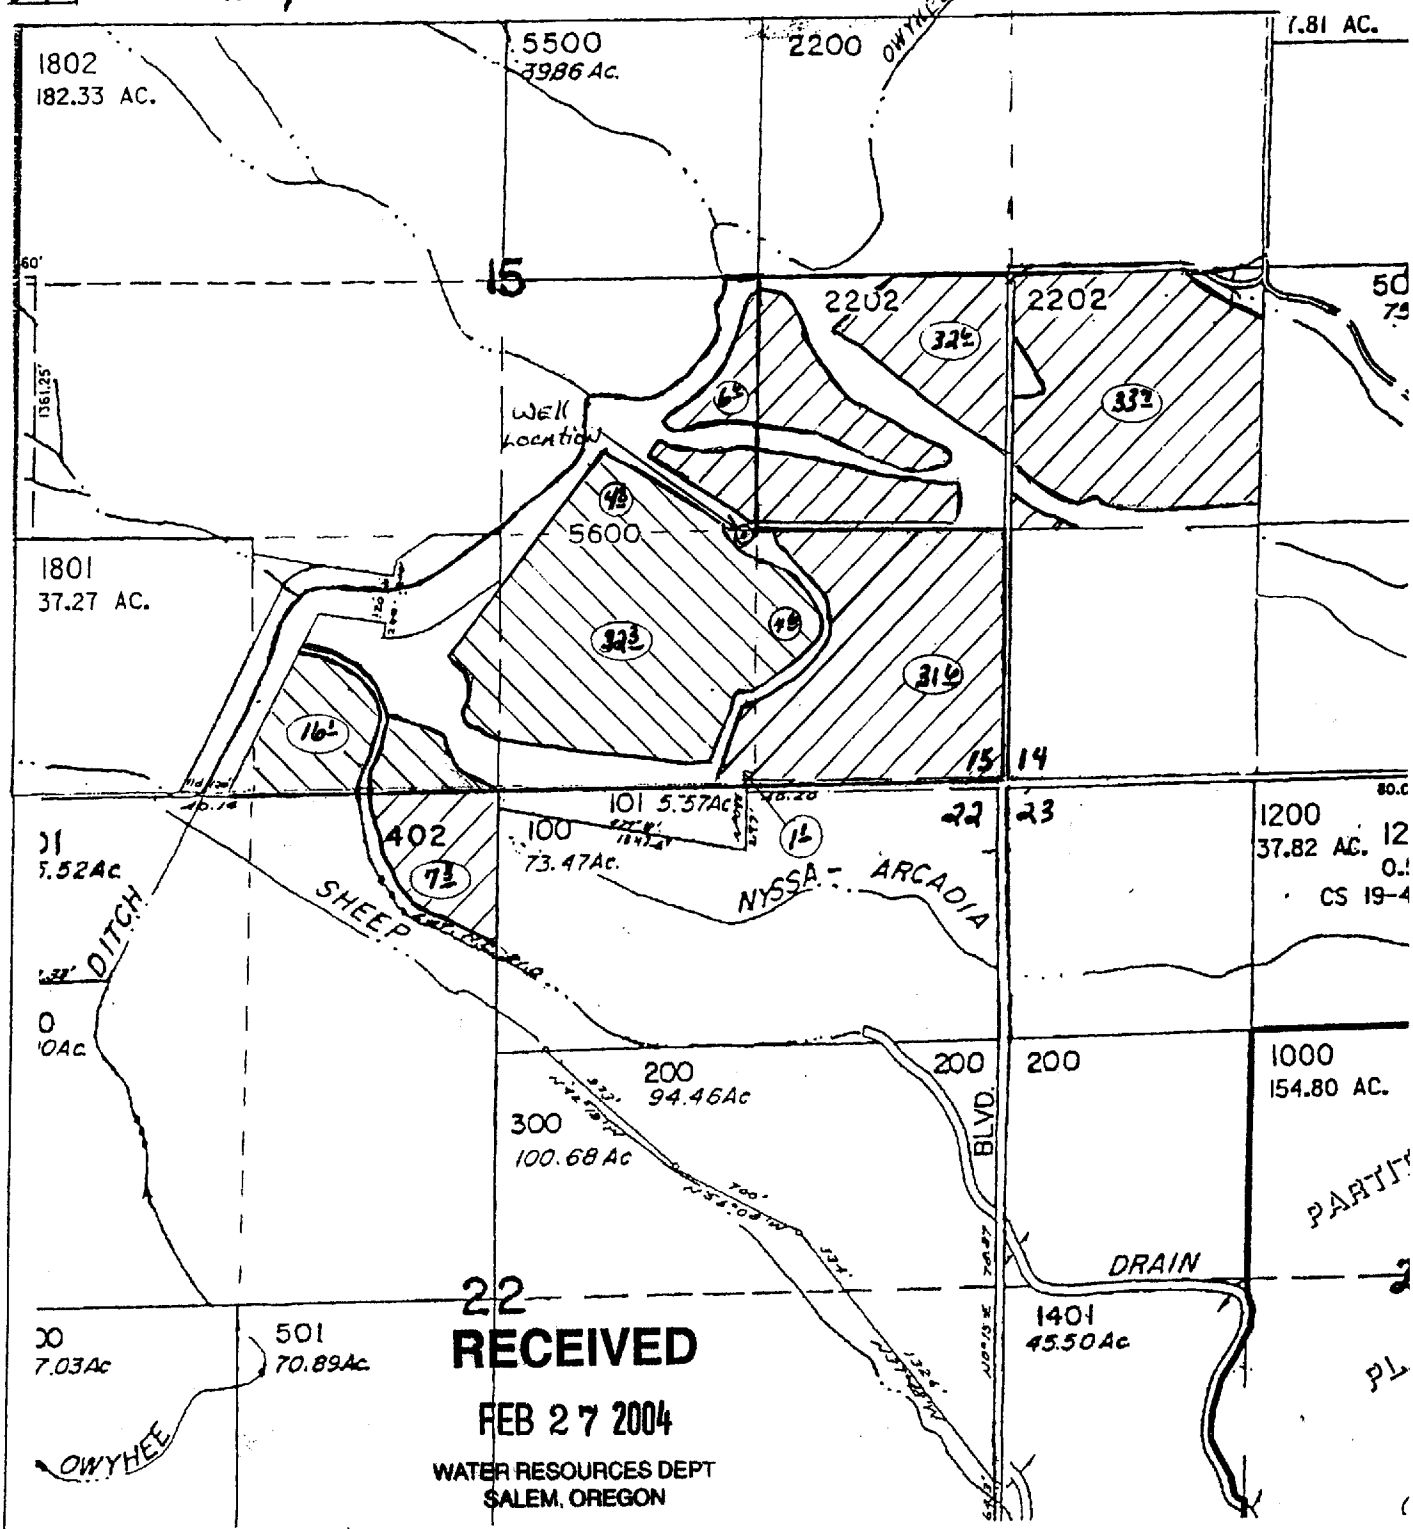

RECEIVED
FEB 27 2004
WATER RESOURCES DEPT
SALEM, OREGON