


T.26S. R.6W. W.M.  
DOUGLAS COUNTY

Scale: 1" = 1000'

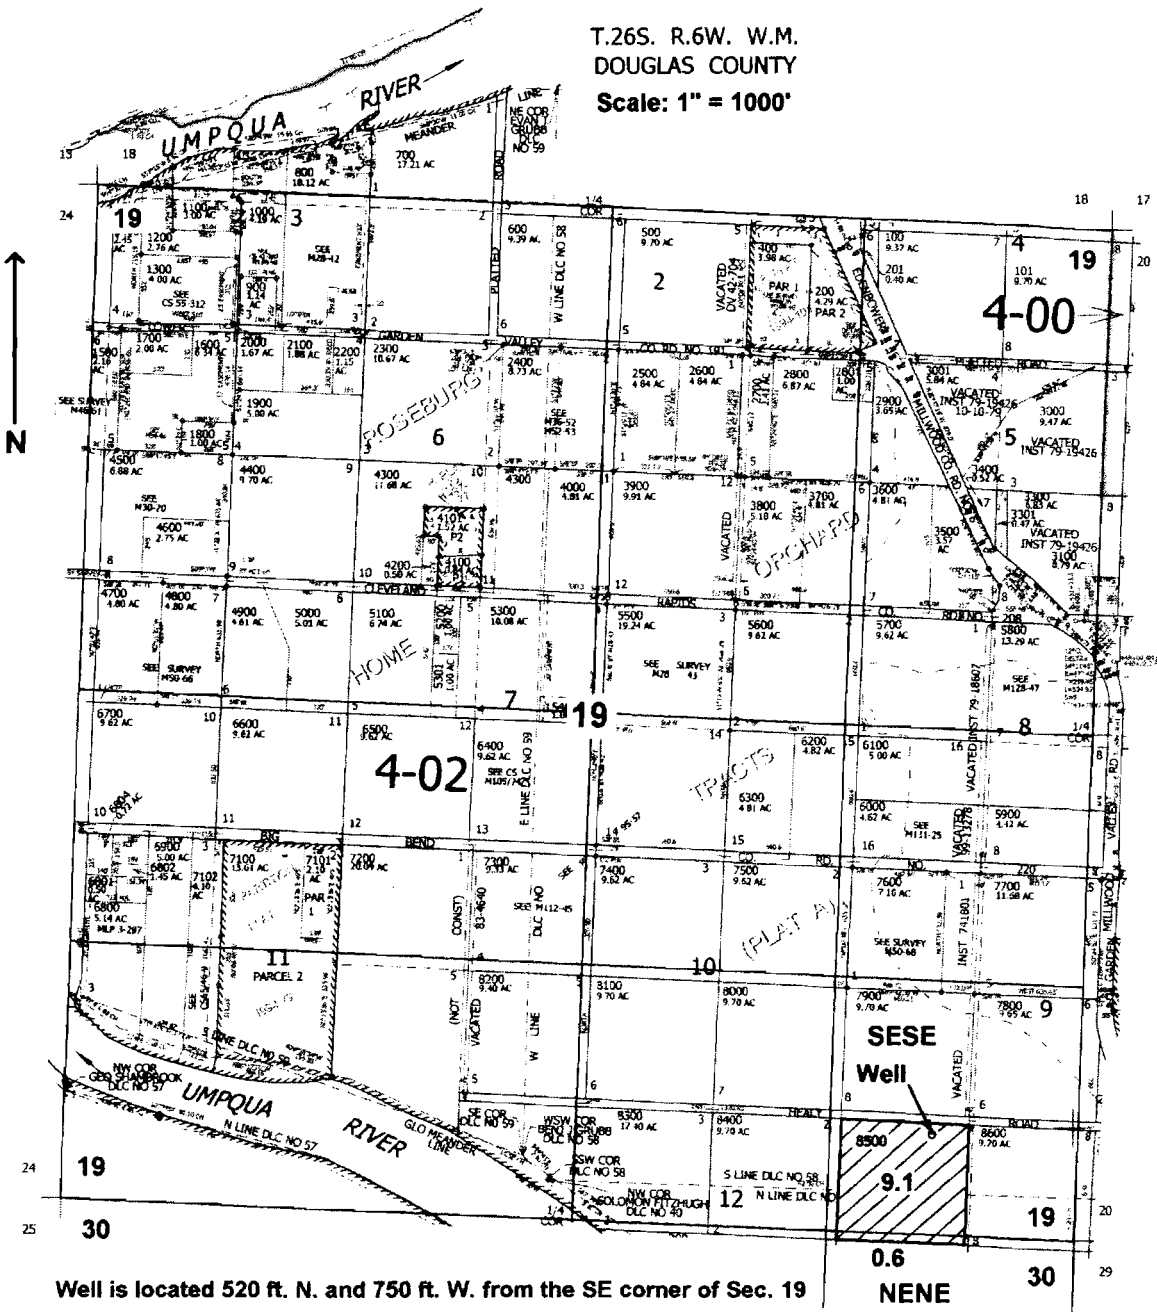

app # G 16324

RECEIVED  
OCT 18 2004  
WATER RESOURCES DEPT  
SALEM, OREGON