


**T 39 S, R 19 E, WM
LAKE COUNTY, OREGON**

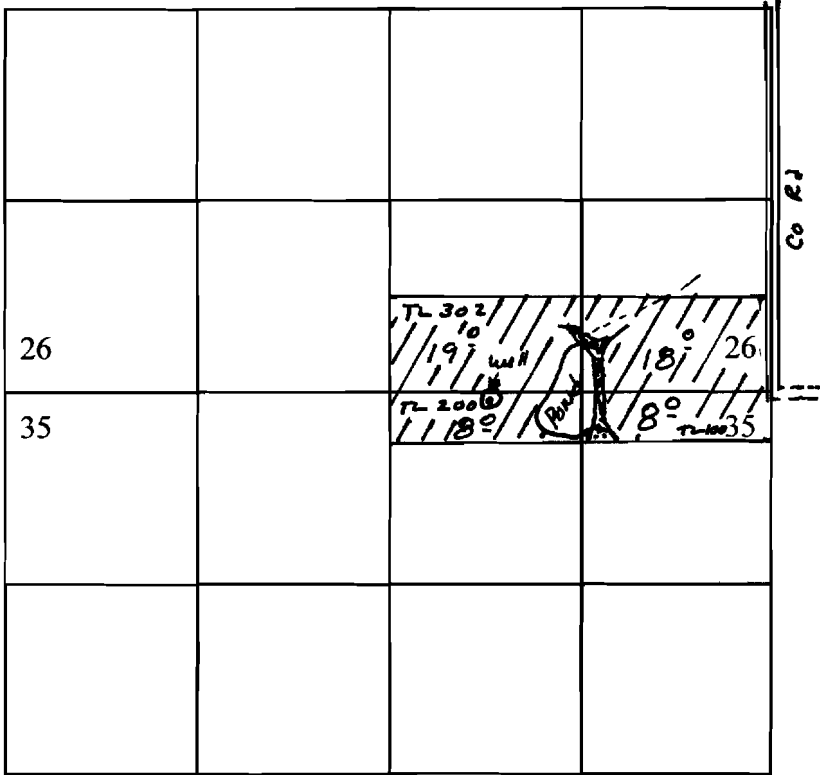

**WELL TO BE LOCATED IN THE NW¼ NE¼, SECTION 35, T 39S,
R.19 E, WM,; 1900' WEST and 20' SOUTH from the NE CORNER,
SECTION 35.**

Scale - 1" = 1320'

app # G 16356

RECEIVED
DEC 16 2004
WATER RESOURCES DEPT
SALEM, OREGON