


**NOTES:**

1. WELL NO. 1 (WATER RIGHT PERMIT NO. G-3125, CERTIFICATE NO. 41968) HAS FAILED AND IS TO BE ABANDONED. THE WATER RIGHT HAS BEEN TRANSFERRED TO WELL NO. 5 (TRANSFER 7867).
2. WELL NO. 3 (WATER RIGHT PERMIT NO. G-3531, CERTIFICATE NO. 41969) IS NO LONGER IN SERVICE AND IS TO BE ABANDONED.
3. WELL NO. 4 (WATER RIGHT PERMIT NO. G-3531, CERTIFICATE NO. 41969) IS CURRENTLY IN SERVICE.
4. WELL NO. 5 WAS CONSTRUCTED IN 1996 AND THE WATER RIGHT WAS TRANSFERRED FROM WELL NO. 1 (WATER RIGHTS TRANSFER 7867).
5. WELL NO. 6 WAS CONSTRUCTED IN 2002 AND THE CITY HAS OBTAINED LIMITED LICENSE NO. 508. WELL NO. 6 IS ON TAX LOT 200.
6. WELL NO. 7 WAS CONSTRUCTED IN 2004. WELL NO. 7 IS ON TAX LOT 400.
8. ALL WATER USE IS WITHIN THE HARRISBURG CITY LIMITS.

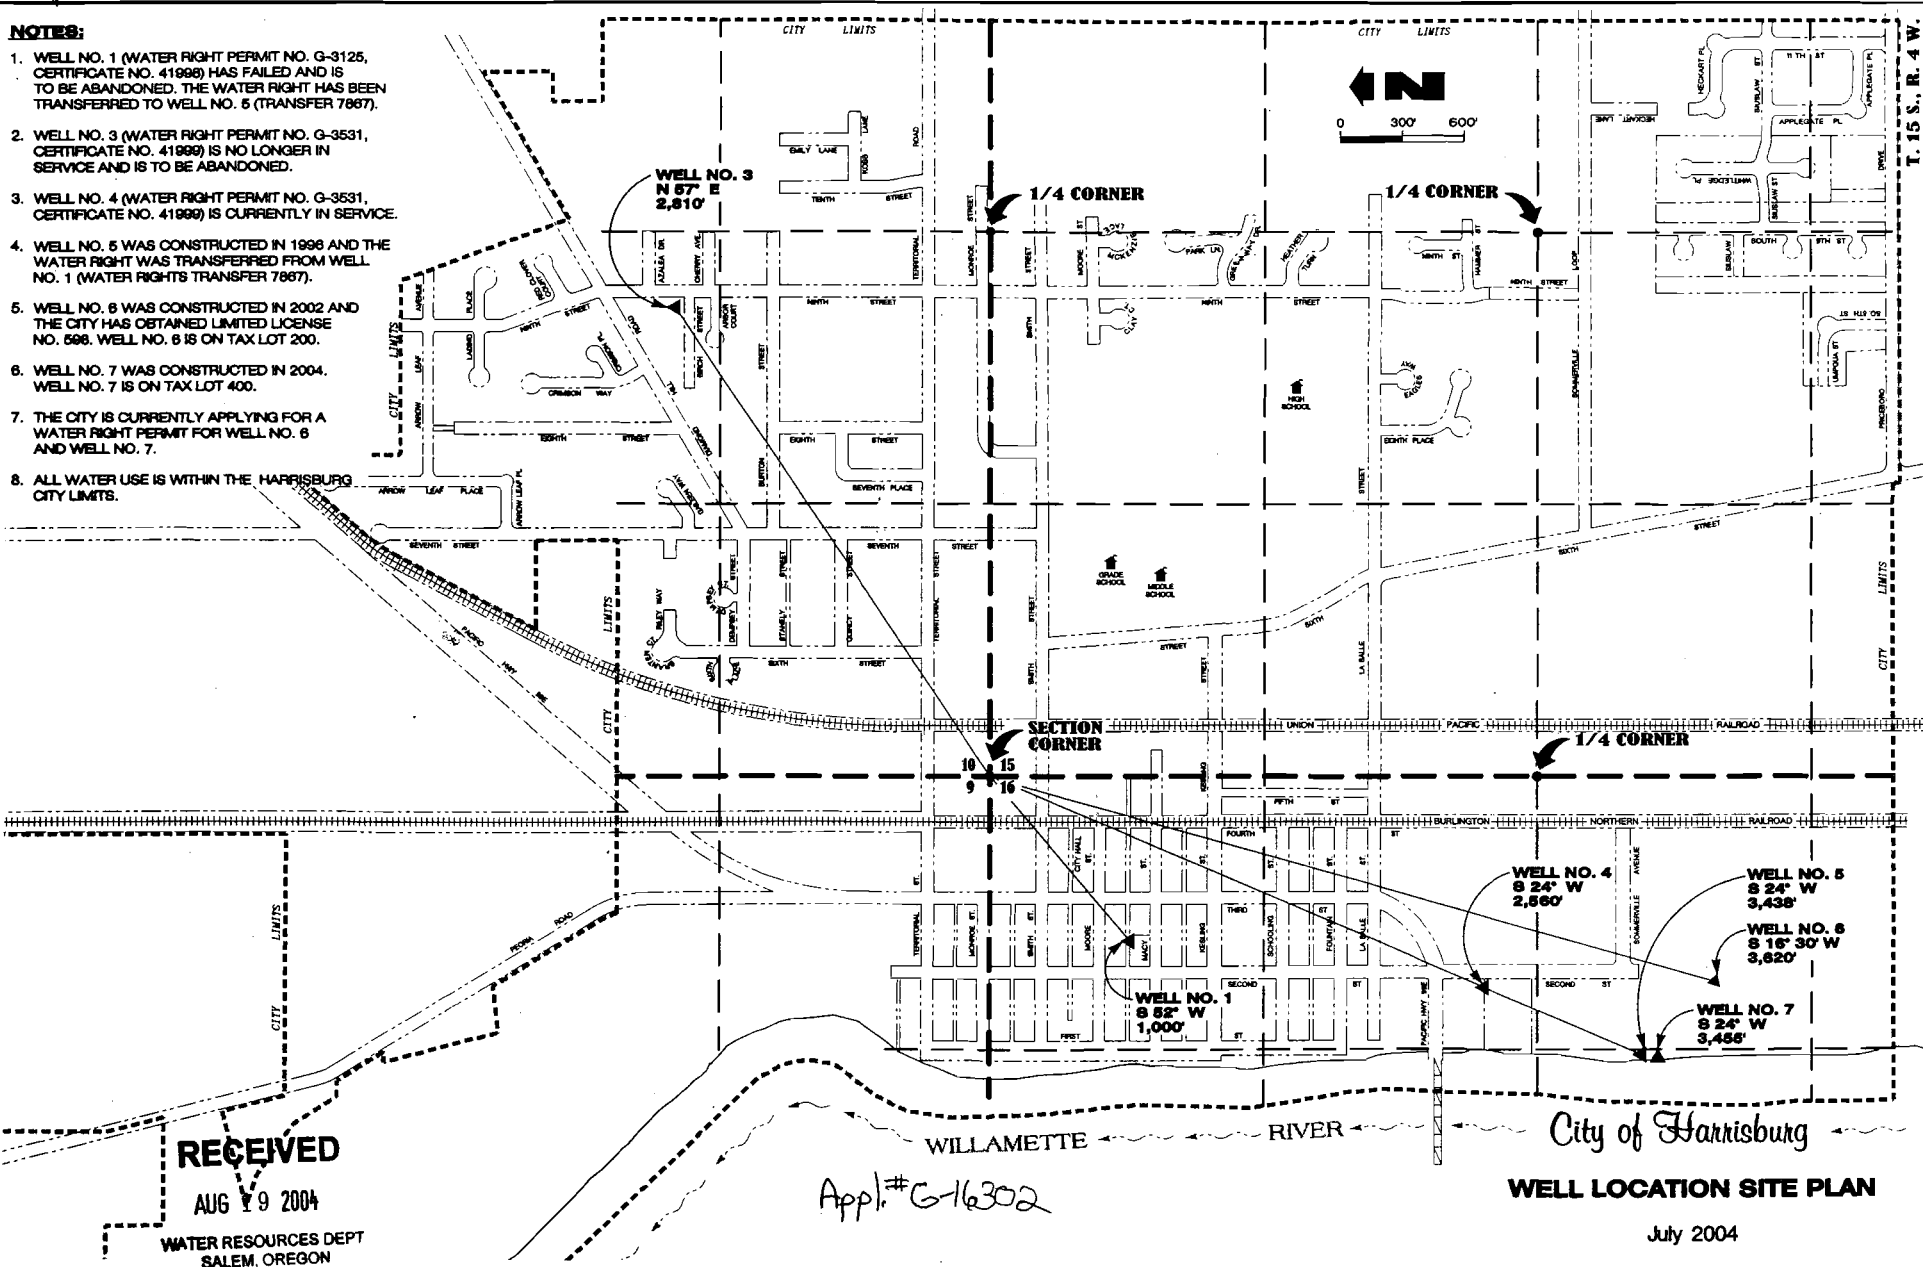

**RECEIVED**

AUG 19 2004

WATER RESOURCES DEPT  
SALEM, OREGON

Appl. # G-16302

**WELL LOCATION SITE PLAN**

July 2004