


1" = 200'

See Map 5N 28D

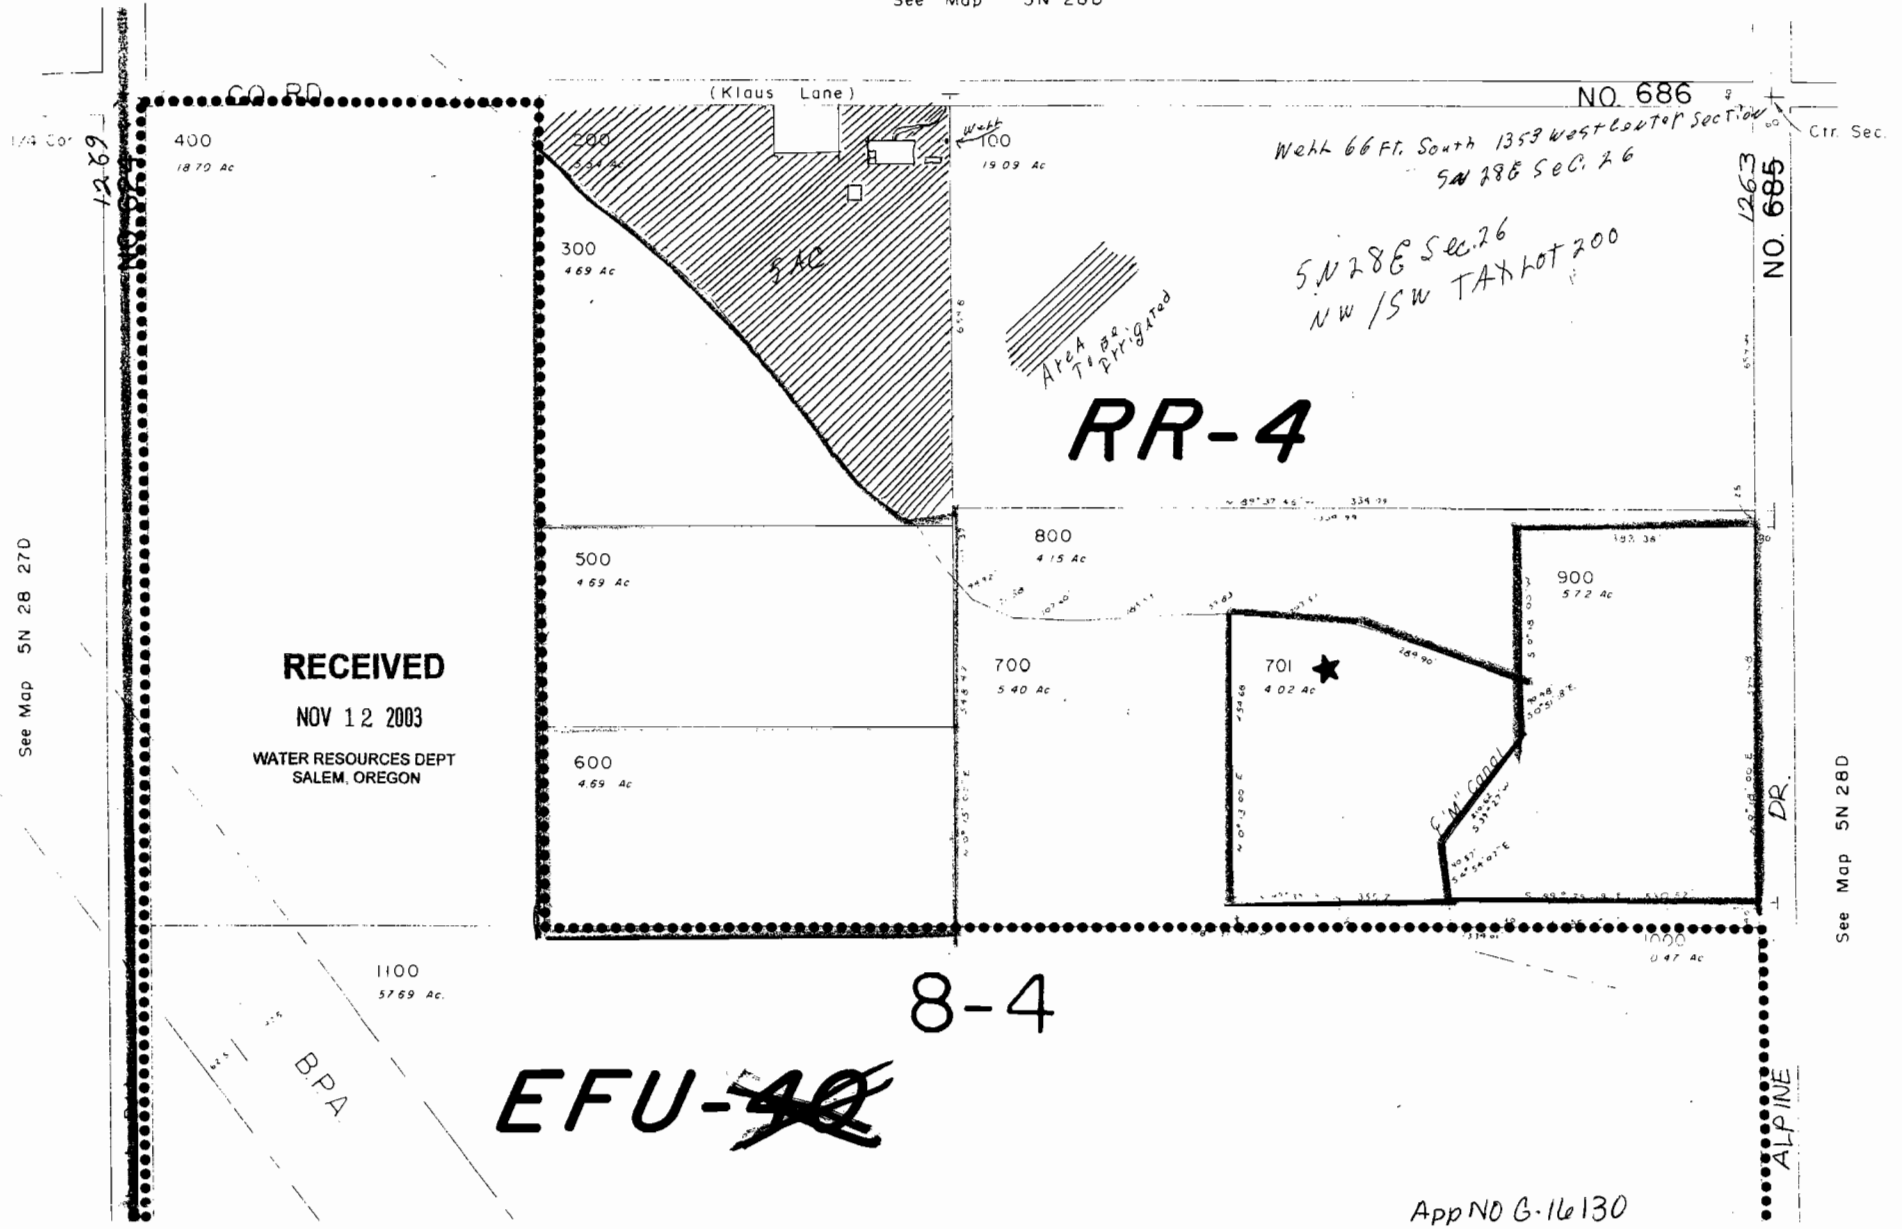

**RECEIVED**

NOV 12 2003

WATER RESOURCES DEPT  
SALEM, OREGON

**RR-4**

**8-4**

**EFU-40**

App NO G-16130

See Map 5N 28 27D

See Map 5N 28D

