


RECEIVED

JUN 15 2005

WATER RESOURCES DEPT.  
SALEM, OREGON

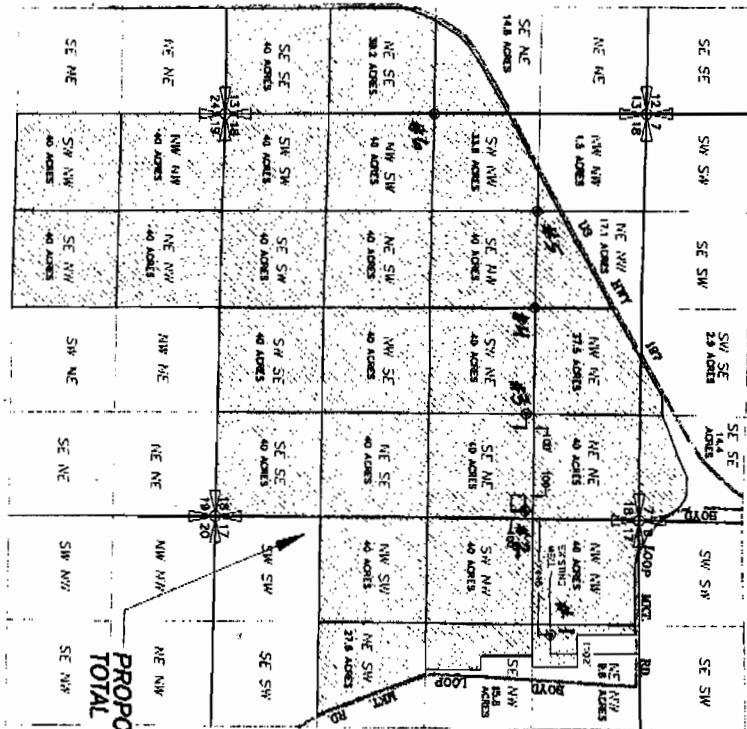


PROPOSED AREA OF USE  
TOTAL AREA = +/- 1014.2 ACRES

APPLICATION MAP FOR IRRIGATION AND AGRICULTURAL USE WATER RIGHTS  
TOWNSHIP 1 SOUTH, RANGE 14 EAST

Township 1 South, Range 13 East

work copy

1 INCH = 1320 FT.

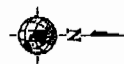

PROPERTY OWNER:  
THE MILLER RANCH COMPANY  
66359 US HWY 197  
DUFUR, OR 97021

APPLICANT:  
THE MILLER RANCH COMPANY

REQUEST:  
GROUNDWATER APPROPRIATION  
FOR PRIMARY IRRIGATION AND  
AGRICULTURAL USE

LEGEND:  
[Stippled Area] PROPOSED IRRIGATION  
[Circle with Dot] PROPOSED WELL  
[Circle] EXISTING WELL

NOTE: THIS MAP WAS PREPARED FOR THE PURPOSE OF IDENTIFYING THE LOCATION OF WATER RIGHTS. THIS MAP IS NOT INTENDED TO PROVIDE DIMENSIONS OR THE LOCATION OF PROPERTY OWNERSHIP LINES.