


app # G 16413

Tax lot map 5N29D
Tax Lot # 2501

T. 5N., R. 29E., Sec. 27 (SESE)
Umatilla Co. Basin # 7

Scale: 1" = 400'

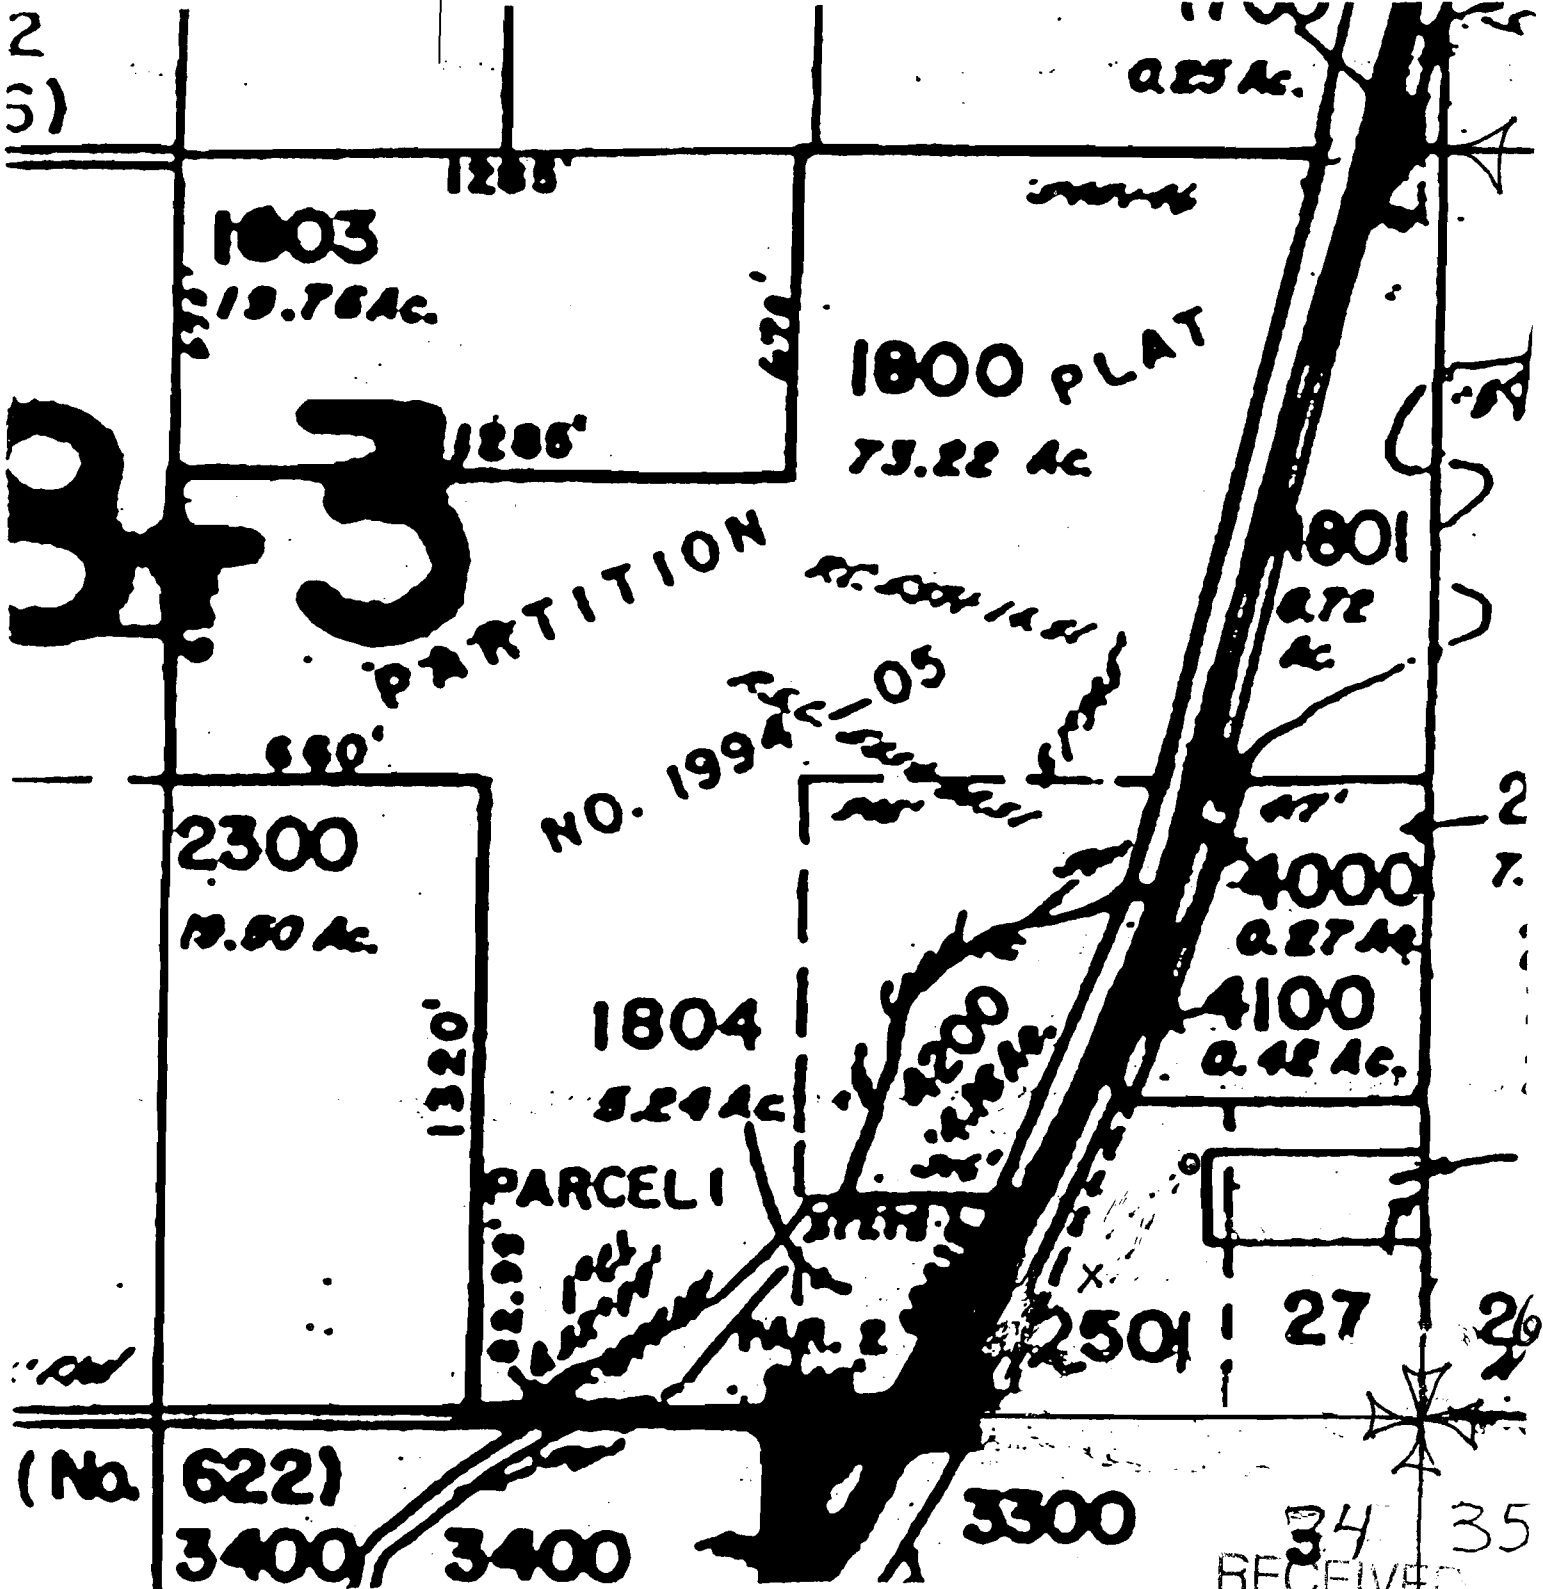

Legend

- ✕ Section Corner
- Well, Location: 533' North From SE Corner and 474' West From SE Corner of section 27 within SE of SE 1/4 of Township 5N R29E Tax Lot 2501
- X Place of use (see place of use map)
- Well Lines

RECEIVED
MAY 14 2005
WATER RESOURCES DEPT
SALEM, OREGON