


T. 8 S. R. 39 E. W. 4

Tax Lot 1700

Well is located:

RECEIVED

APR 04 2005
WATER RESOURCES DEPT.
SALEM, OREGON

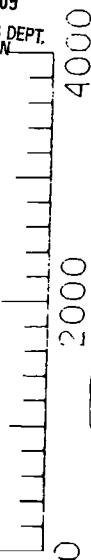

SCALE IN FEET
1" = 1000'

WELL LOCATION DESCRIPTION:

2750' E. & 150' S. fr.

NW COR SEC 6, T. 8 S.,

R. 39 E. W. 4

RECEIVED

MAR 23 2005
WATER RESOURCES DEPT.
SALEM, OREGON

INSERT
PARCEL 3300


SCALE 1" = 100'

App No G-16431

CEN.
SEC. 8

THIS MAP WAS PREPARED FOR
ASSESSMENT PURPOSE ONLY

PROP CLASS 551
CODE 518 ACRES 134.25
MAP 085 39E T.L 1700
Baker County

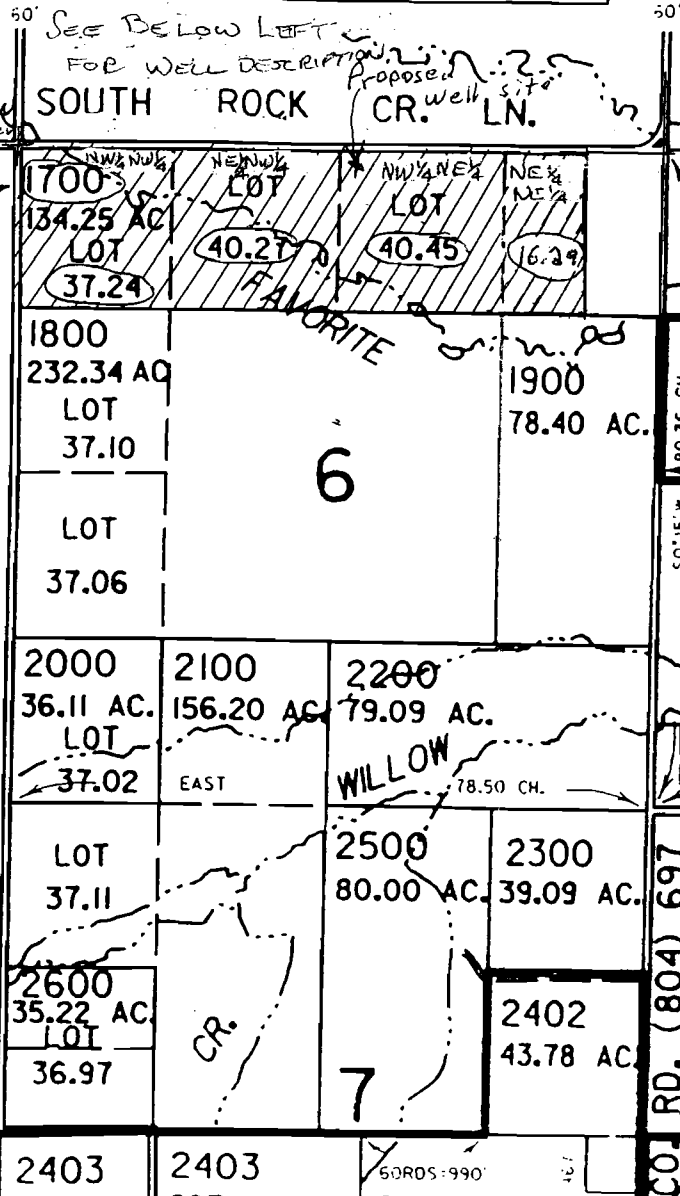

6

7

5-18

SE
8

CC
LN.

S
R

CO. RD. (801) 635

CO. RD. (804) 697

CO. RD. (806) 699