

SECTION 23 T.2N. R.10E. W.M.
HOOD RIVER COUNTY

Hood River Basin

1"=400'


WORK COPY

THIS MAP WAS PREPARED FOR ASSESSMENT PURPOSE ONLY


RECEIVED

MAY 20 2005

WATER RESOURCES DEPT
SALEM, OREGON

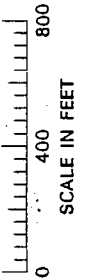

Map Legend	
Map Symbols	
	Well
	Open Ditch
	Pipeline
	Property Line
Place of Use	
	Supplemental Water Rights
Sheppard Orchards, Inc. Hood River, Oregon	
Section 2N-10-23	
Scale 1" = 400' cms	

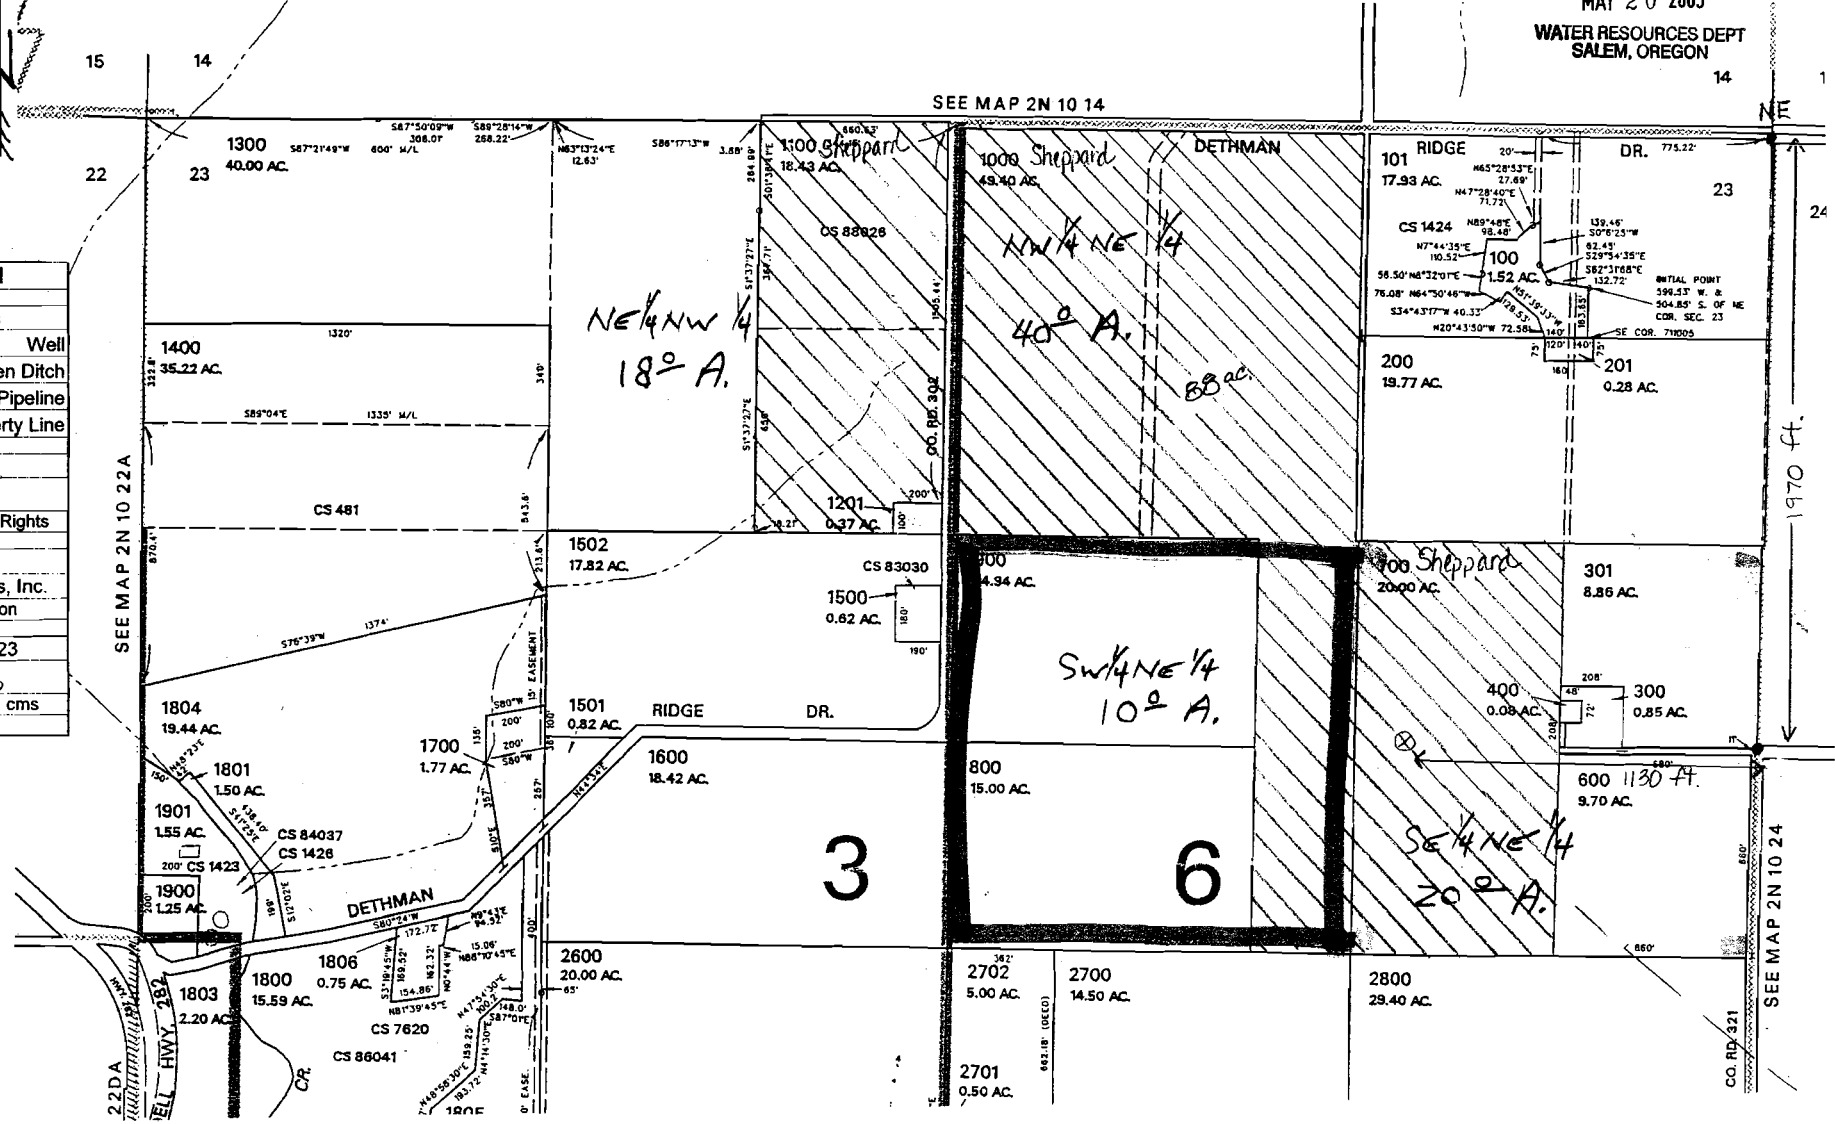

app no G-16464
Permit no

SEE MAP 2N 10 24

CO. RD. 321

1970 ft.

14

23

24

24

