


# AVION WATER COMPANY, INC

## APPLICATION MAP FOR A PERMIT TO USE GROUNDWATER

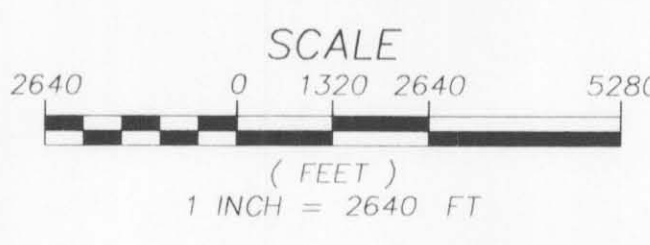


NOTE: THIS MAP WAS PREPARED FOR THE PURPOSE OF IDENTIFYING THE LOCATION OF WATER RIGHTS. THIS MAP IS NOT INTENDED TO PROVIDE DIMENSIONS OR THE LOCATION OF PROPERTY OWNERSHIP LINES.

NOTE: THIS DRAWING WAS ORIGINALLY PREPARED AND PROVIDED BY AVION WATER COMPANY, INC AND SUBSEQUENTLY MODIFIED BY W&H PACIFIC




920 Emkay, Suite 100  
Bend, Oregon 97702-1000  
(541) 388-4229  
whpacific.com

SHEET 2

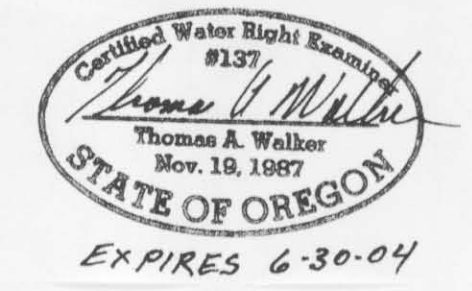

171420  
app no 6-16060

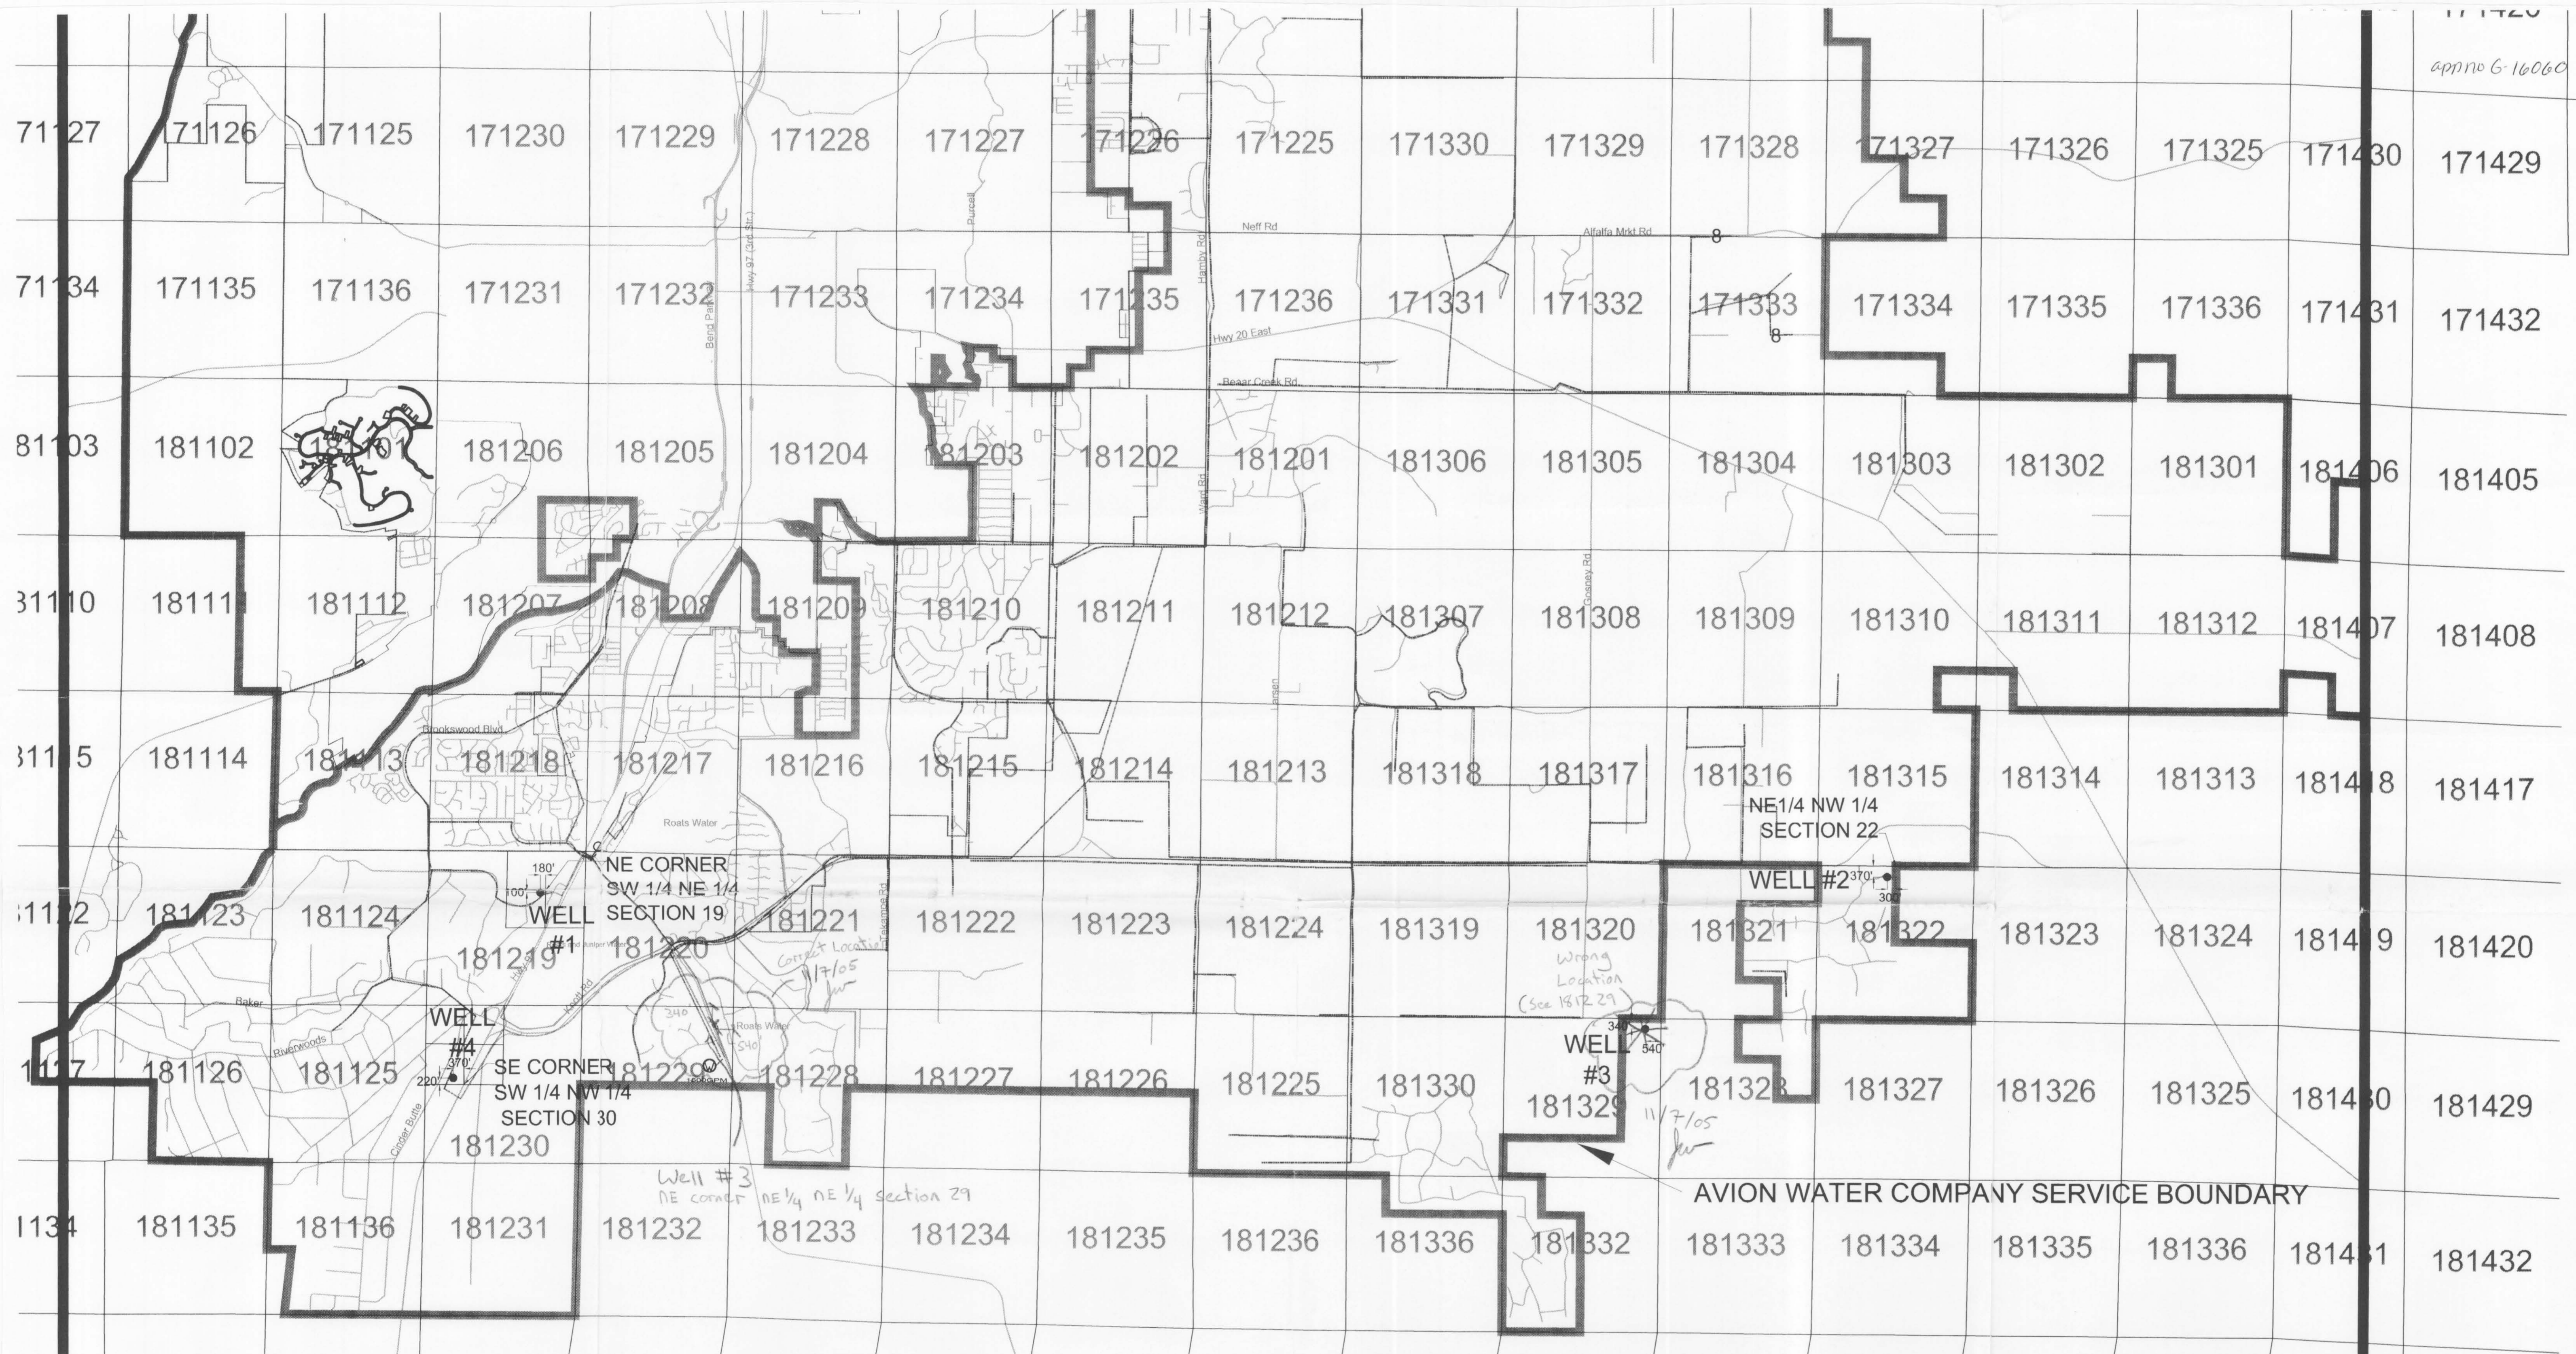

# AVION WATER COMPANY, INC

## APPLICATION MAP FOR A PERMIT TO USE GROUNDWATER

NOTE: THIS MAP WAS PREPARED FOR THE PURPOSE OF IDENTIFYING THE LOCATION OF WATER RIGHTS. THIS MAP IS NOT INTENDED TO PROVIDE DIMENSIONS OR THE LOCATION OF PROPERTY OWNERSHIP LINES.

NOTE: THIS DRAWING WAS ORIGINALLY PREPARED AND PROVIDED BY AVION WATER COMPANY, INC AND SUBSEQUENTLY MODIFIED BY W&H PACIFIC



RECEIVED  
JUL 28 2003  
WATER RESOURCES DEPT  
SALEM, OREGON

920 Emkay, Suite C-100  
Bend, Oregon  
97702-1041  
(541)388-4255  
(541)388-4229 Fax  
whpacific.com

SHEET 1 OF 3

