


~~RECEIVED~~

~~JUL - 3 1990~~

~~WATER RESOURCES DEPT  
SALEM, OREGON~~

# T 23 S, R 32 1/2, WM

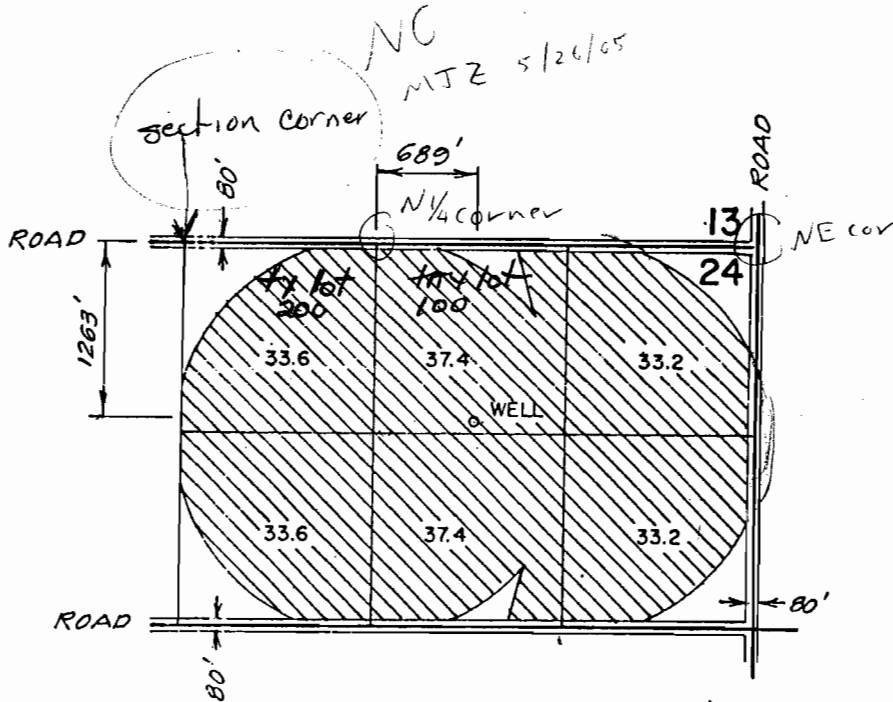

1" = 1320'

APPLICATION MAP for  
Joseph Langenfeld

**RECEIVED**  
MAR 21 2005  
WATER RESOURCES DEPT  
SALEM, OREGON


app # G16420

**RECEIVED**  
MAR 10 2005  
WATER RESOURCES DEPT  
SALEM, OREGON

JOE LANGENFELD

BURNS, OR

## WATER RIGHT APPLICATION MAP

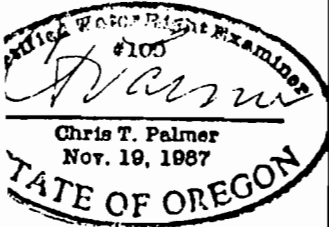

Scale: 4" = 1 mi	Date: JUNE 1990	Job: 954
Dsn:	<b>M.A.P.'s</b> <b>M. A. PALMER &amp; SONS, INC.</b> ENGINEERING & SURVEYING 254 N. Alder - Box 61 Burns, Oregon 97720	Sht. No. 1
Drn: CTP		of 1
Ckd:		