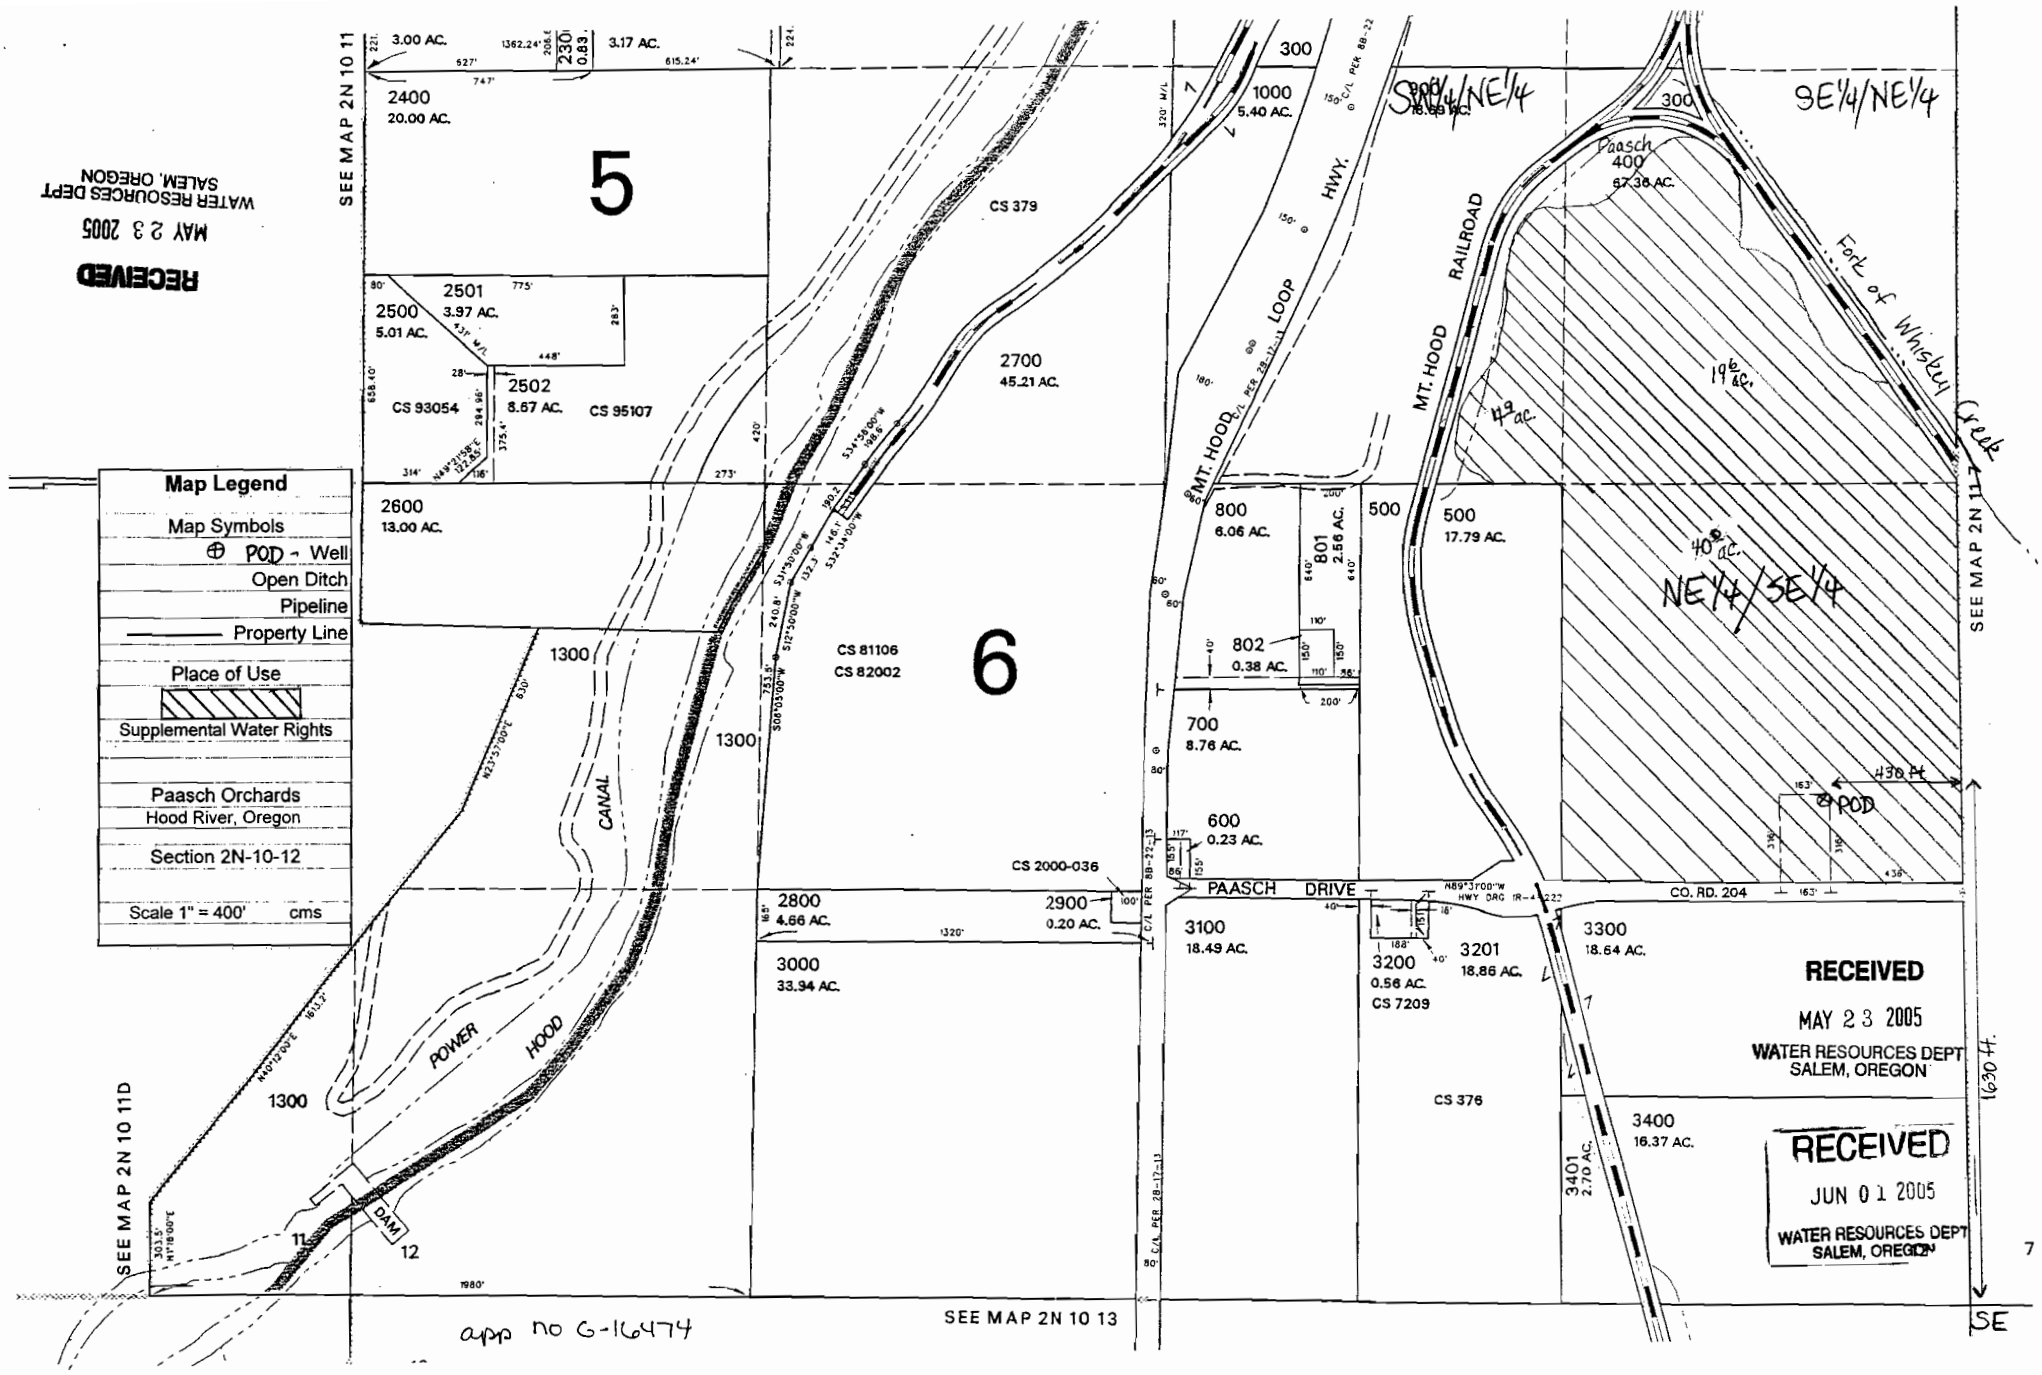
Map Legend
Map Symbols
POD - Well
Open Ditch
Pipeline
Property Line
Place of Use
Supplemental Water Rights
Paasch Orchards
Hood River, Oregon
Section 2N-10-12
Scale 1" = 400' cms
SEE MAP 2N 10 11
SEE MAP 2N 10 11D
SEE MAP 2N 10 13
SEE MAP 2N 11
5
6
2400
20.00 AC.
2500
5.01 AC.
2501
3.97 AC.
2502
8.67 AC.
2600
13.00 AC.
2700
45.21 AC.
CS 379
CS 93054
CS 95107
CS 81106
CS 82002
CS 2000-036
1300
CANAL
POWER
HOOD
DAM
11
12
2800
4.66 AC.
2900
0.20 AC.
3000
33.94 AC.
1000
5.40 AC.
300
800
6.06 AC.
801
2.56 AC.
802
0.38 AC.
700
8.76 AC.
600
0.23 AC.
500
17.79 AC.
MT. HOOD LOOP HWY.
MT. HOOD RAILROAD
PAASCH DRIVE
CO. RD. 204
3100
18.49 AC.
3200
0.56 AC.
CS 7209
3201
18.86 AC.
CS 376
3300
18.64 AC.
3400
16.37 AC.
3401
2.70 AC.
400
67.38 AC.
Paasch
Fork of Winsley Creek
19 ac.
49 ac.
40 ac.
NE¼/SE¼
SE¼/NE¼
436 ft
POD
1630 ft.
SE
RECEIVED
MAY 23 2005
WATER RESOURCES DEPT
SALEM, OREGON
RECEIVED
JUN 01 2005
WATER RESOURCES DEPT
SALEM, OREGON
RECEIVED
MAY 23 2005
WATER RESOURCES DEPT
SALEM, OREGON
app no G-16474

7