


T. 30 S., R. 15 W., W.M.

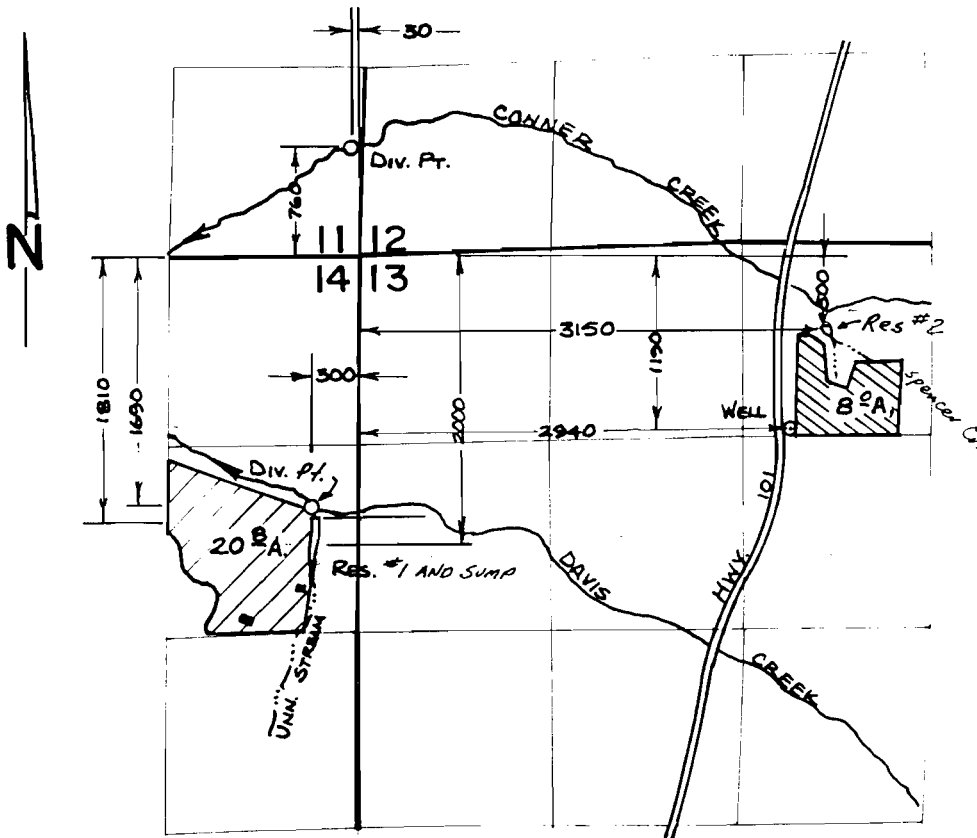

SCALE : 4" = 1 MILE

No. D-12341

FINAL PROOF SURVEY UNDER

G-9494	G-9088
R-59563	R-8204
59564	45328
61757	46101
G-11296	G10489
R-68151	R10479
68023	49345
68354	49429

Application No. 68023 Permit No. 49345
 68354 Permit No. 49429



Sump
 Reservoir
 Unn. Stream & Reservoir
 Davis Creek
 Well
 Spencer Creek Reservoir
 Spencer Cr. & Res.
 Conner Creek

IN NAME OF

HARRY G. SPENCER

Surveyed 7/26 & 28, 19.88, by J.M. SCHMORDE.