


T. 6 S., R. 3 W. W.M.

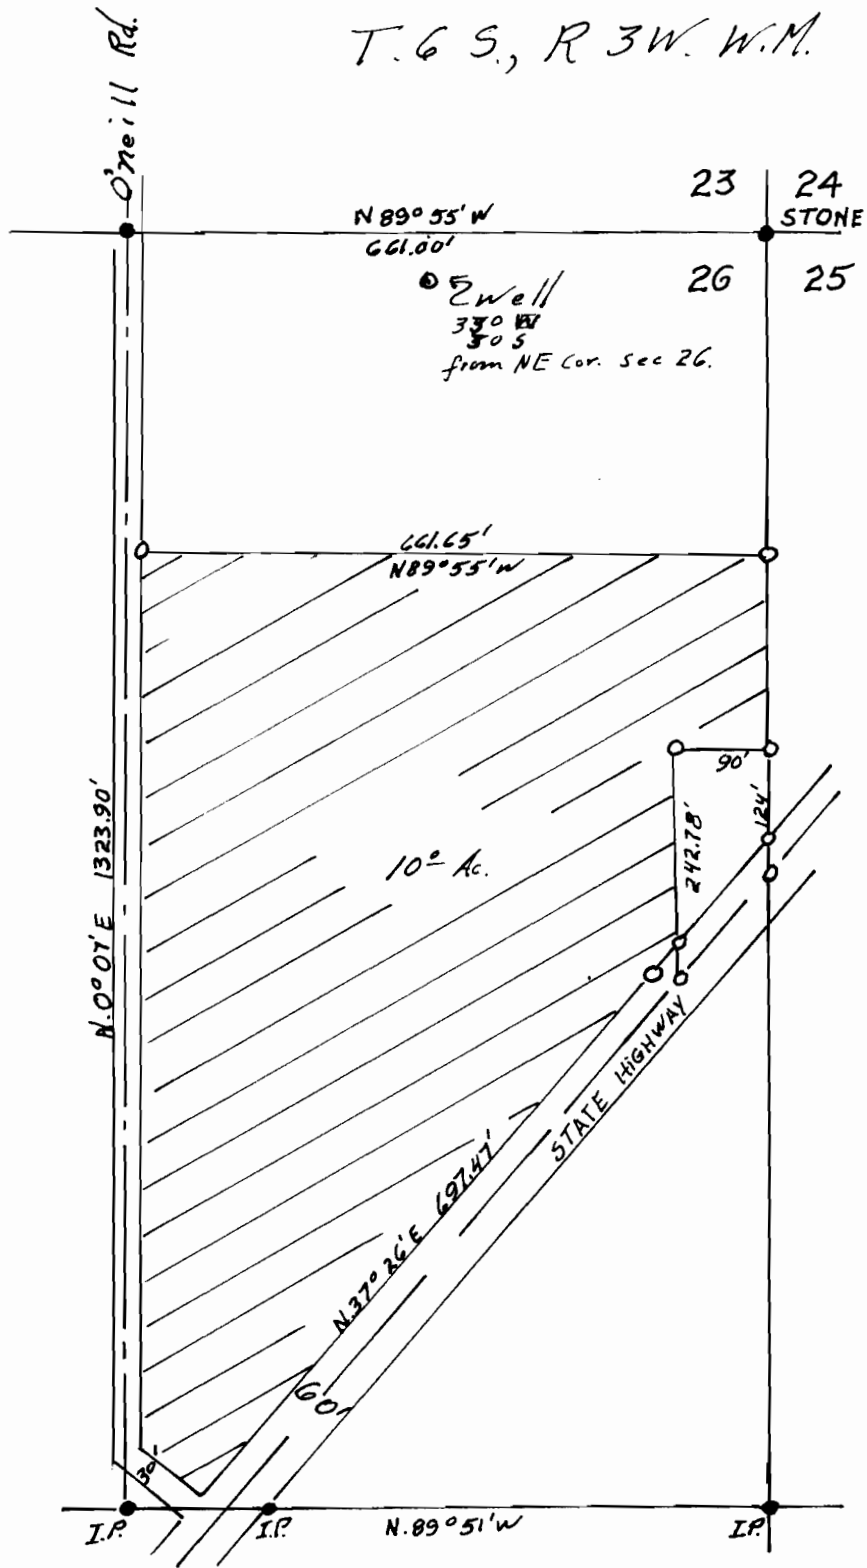

1" = 200'

Application No. G-1759  
Permit No. G-1607