
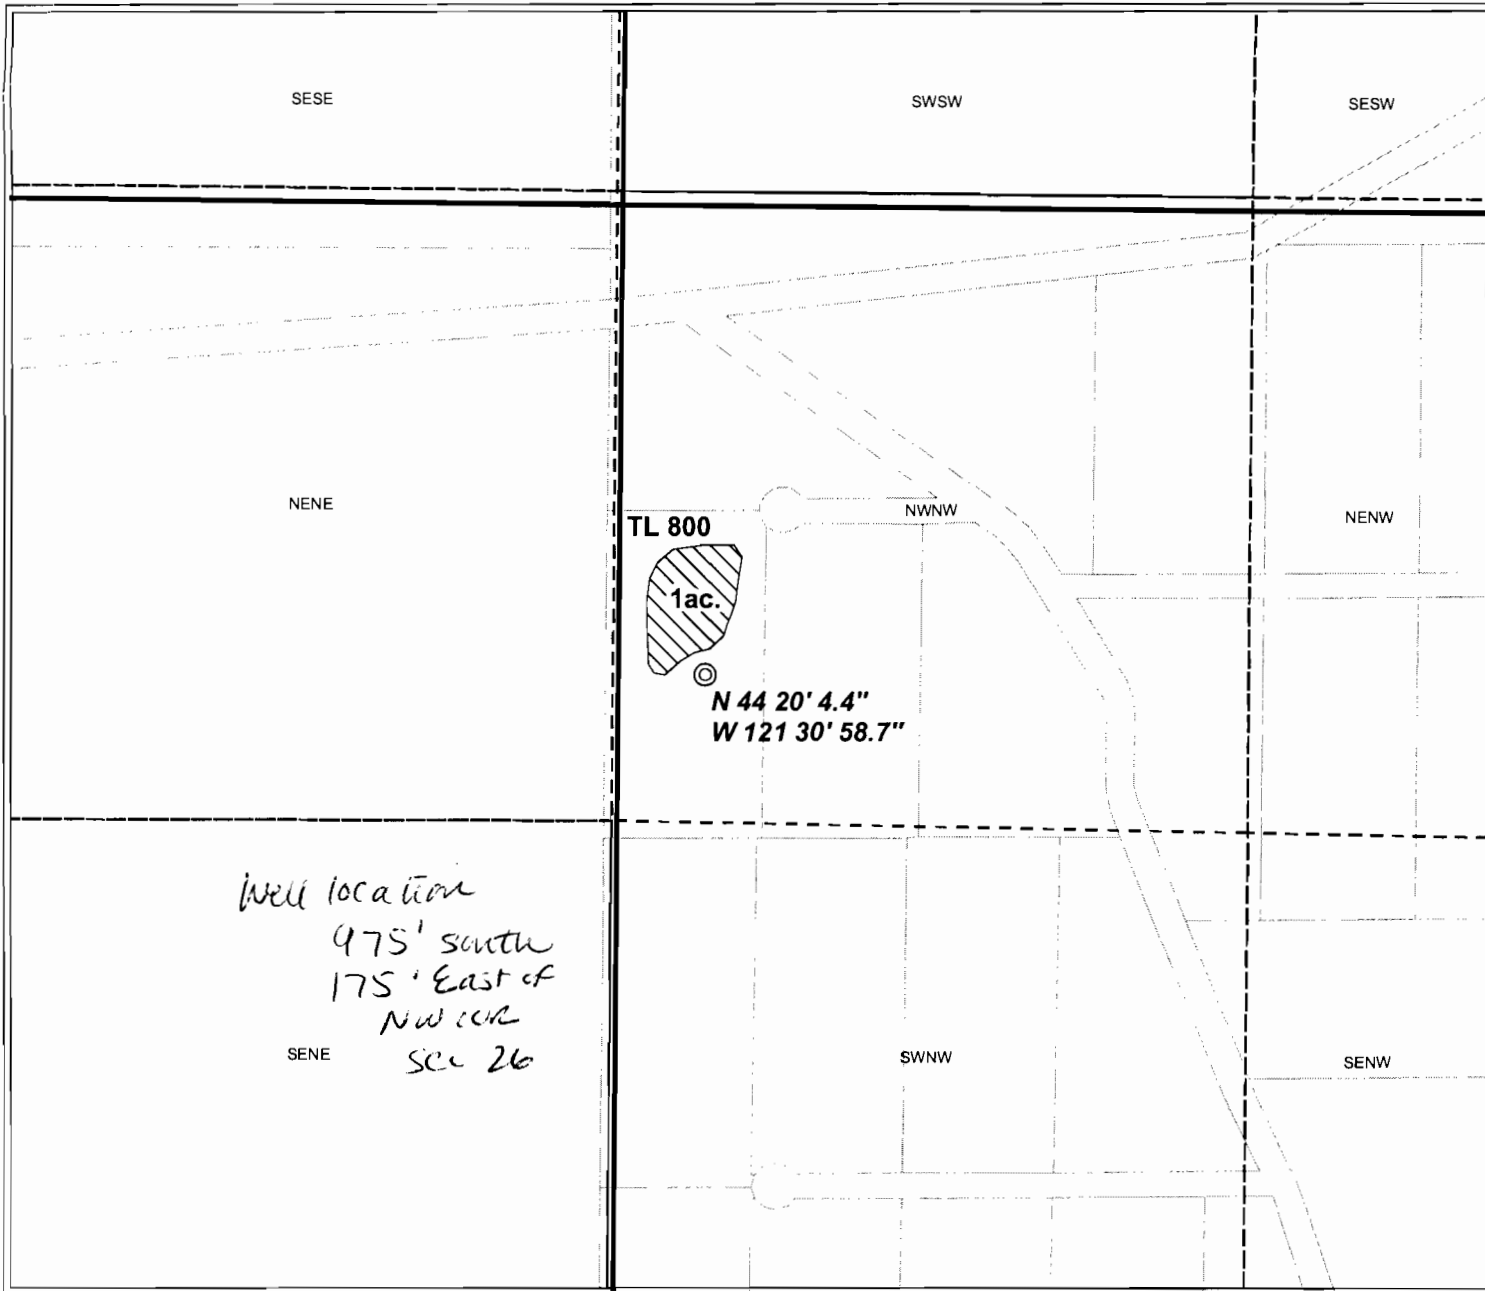


Superseding

GROUNDWATER APPLICATION MAP

T14S. R10E. SECTION 26

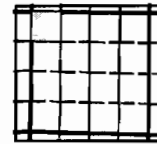

Well location
 475' south
 175' East of
 NW cor
 sec 26

APPLICATION FOR GROUNDWATER PERMIT

FOR

David Swenson

Tax Lot 800

App. G-16258
 Permit

Red wcd
 7/7/04



Proposed Place of Use



Approximate Well Location



1/16 Section Lines



This map is distributed "AS-IS" without warranties of any kind, either expressed or implied, including but not limited to warranties of suitability to a particular purpose or use. This map is intended for use only at the published scale and is provided for informational purposes only.

Geo-Spatial Solutions, Inc.
www.geospatialolutions.com

1 inch equals 400 feet
 Date Created: May 24, 2004