

N

1

Appl. #

Ubaldo Sanchez - Tax Lot 600

Irrigation/Nursery Use:

11.3 Acres - NW 1/4, SE 1/4


1.3 Acres - SW 1/4, NE 1/4

T. 4 S., R 2 E., Section 30

POA Location:

595' East and 50' South  
from the NW Corner of  
the SE 1/4, T. 4 S., R 2 E., Sec 30

Scale: 1" = 1320'

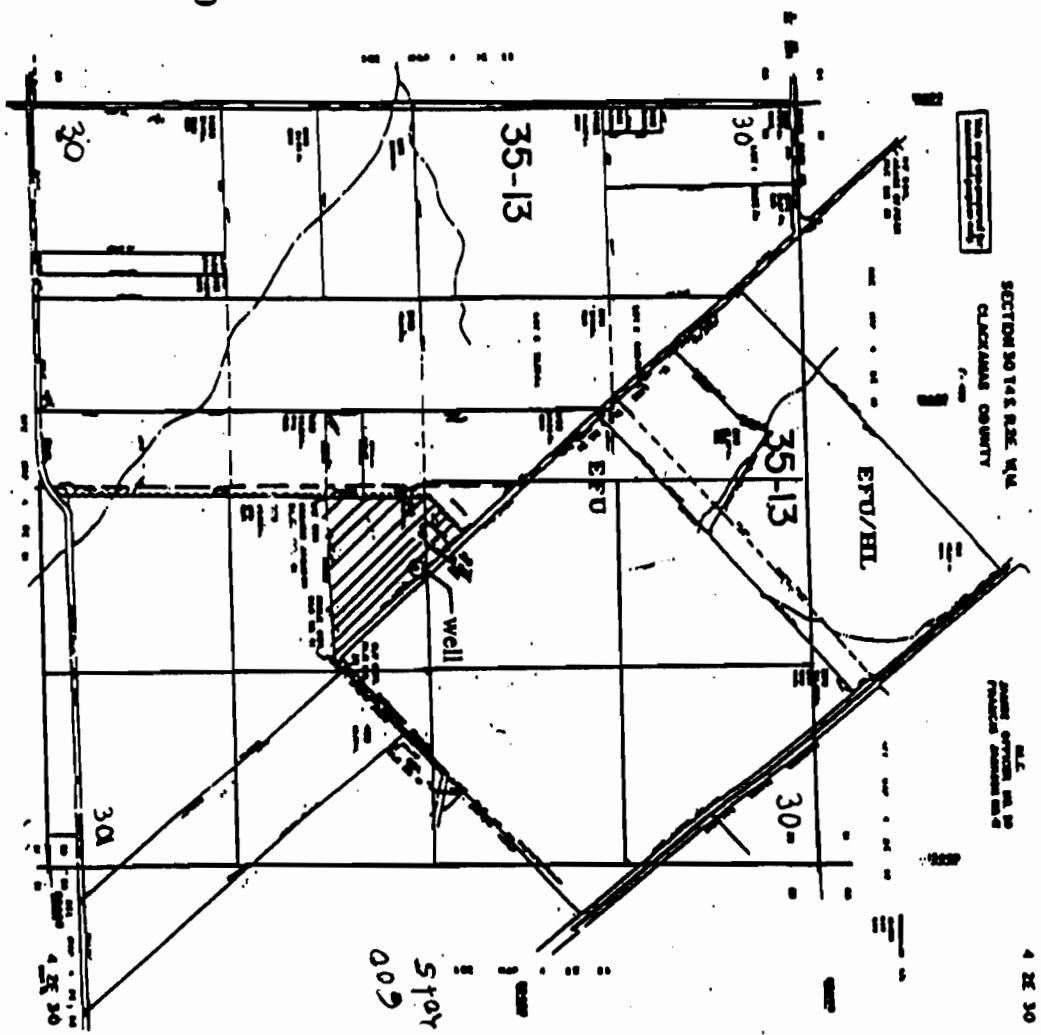

app no G-16513

RECEIVED  
 AUG 22 2005  
 WATER RESOURCES DEPT  
 SALEM, OREGON