apno 6-1587

TAX LOT # 1500 SEC. #2 1N 14E

DIRECTIONS

S. FROM NW CORNER SEC 2 3,036'
THEN E. 1,188' to well

Scale 4" = 1 MILE

SEE MAP 2N 14

N1

WORK COPY

RECEIVED
DEC 21 2005
WATER RESOURCES DEPT
SALEM, OREGON

2N 14

&

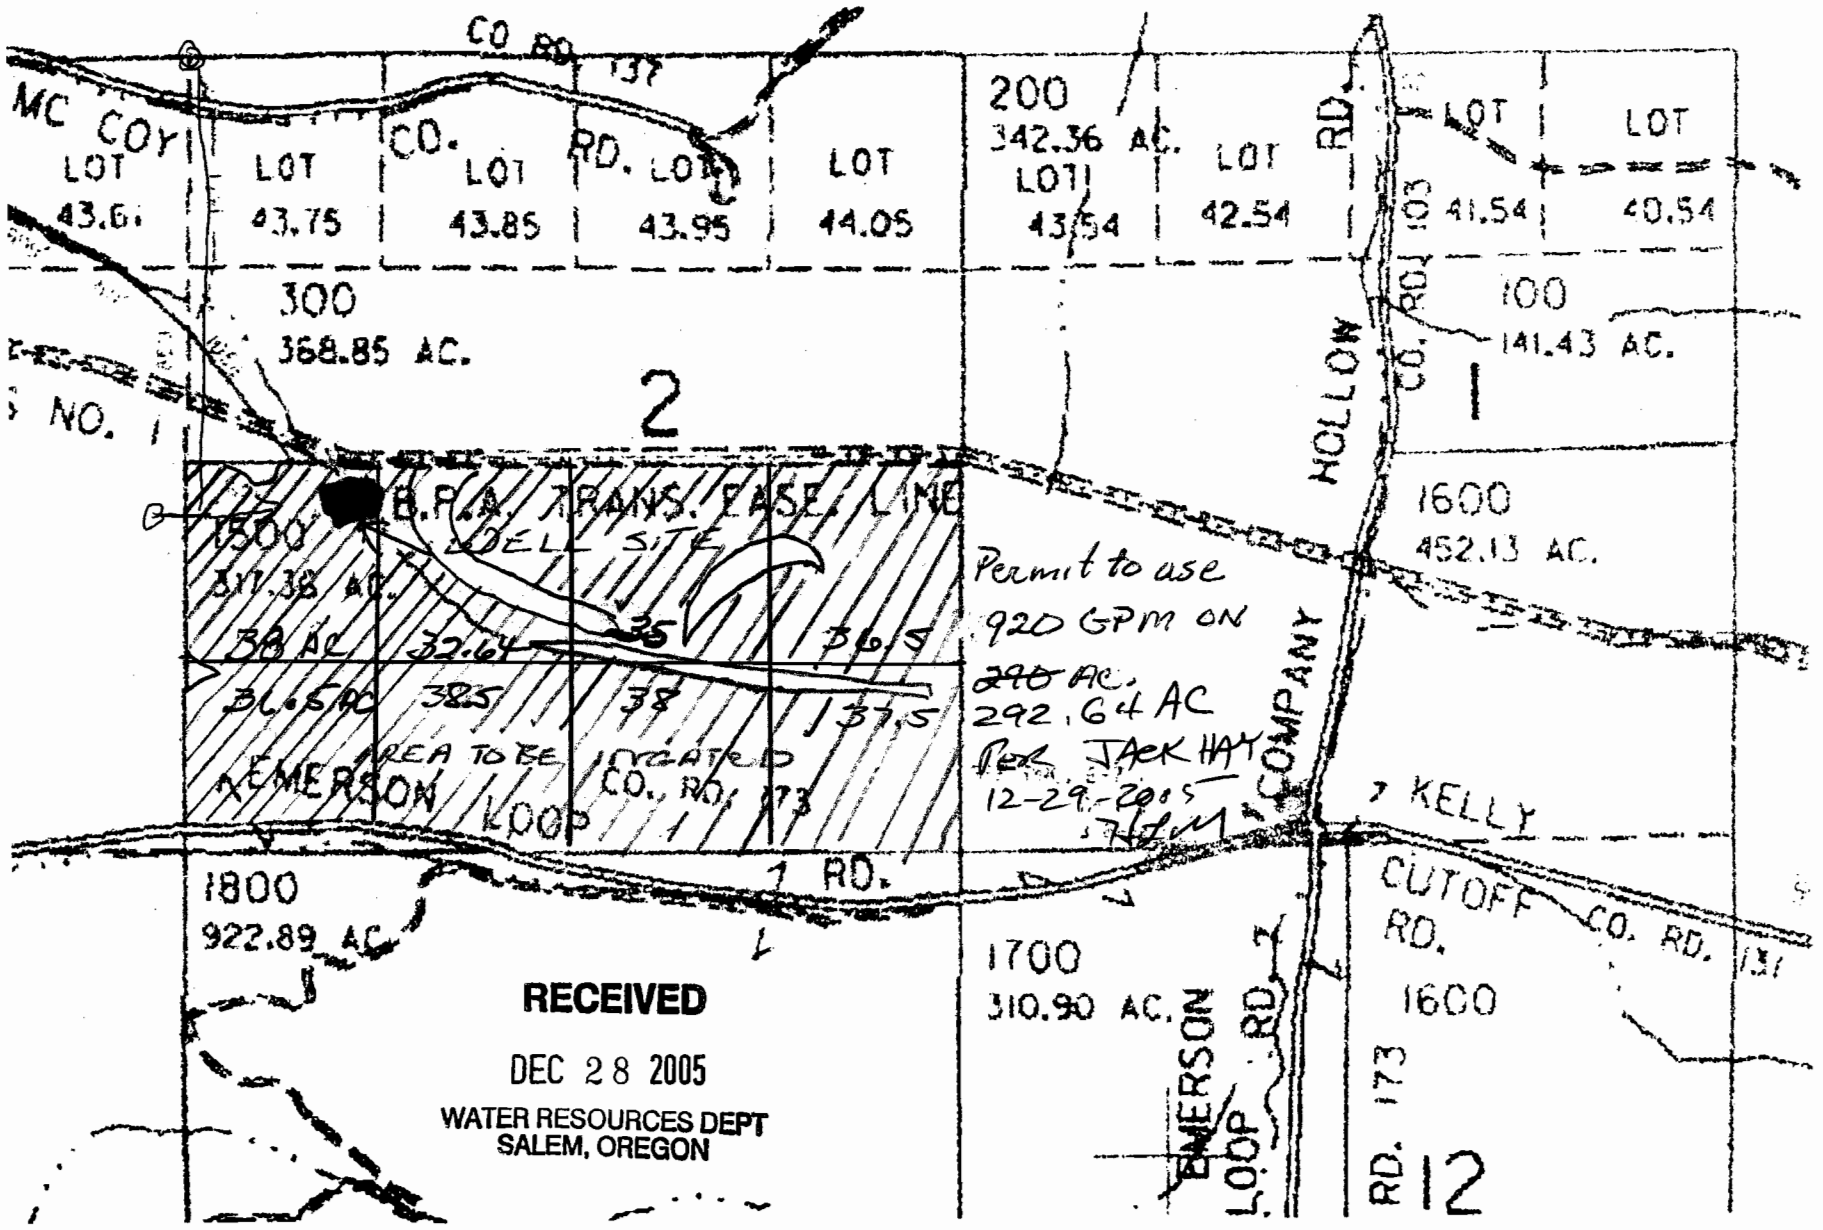

RECEIVED
DEC 28 2005
WATER RESOURCES DEPT
SALEM, OREGON