


LOCATION WELL
 from NW CORNER
 SECTION 30

1125 FT SOUTH
 4125 FT EAST


SECTION 30 T1S R2W WM
 WASHINGTON COUNTY OREGON

SCALE 1" = 400' 500 FT
 SEE MAP
 IS 2 19

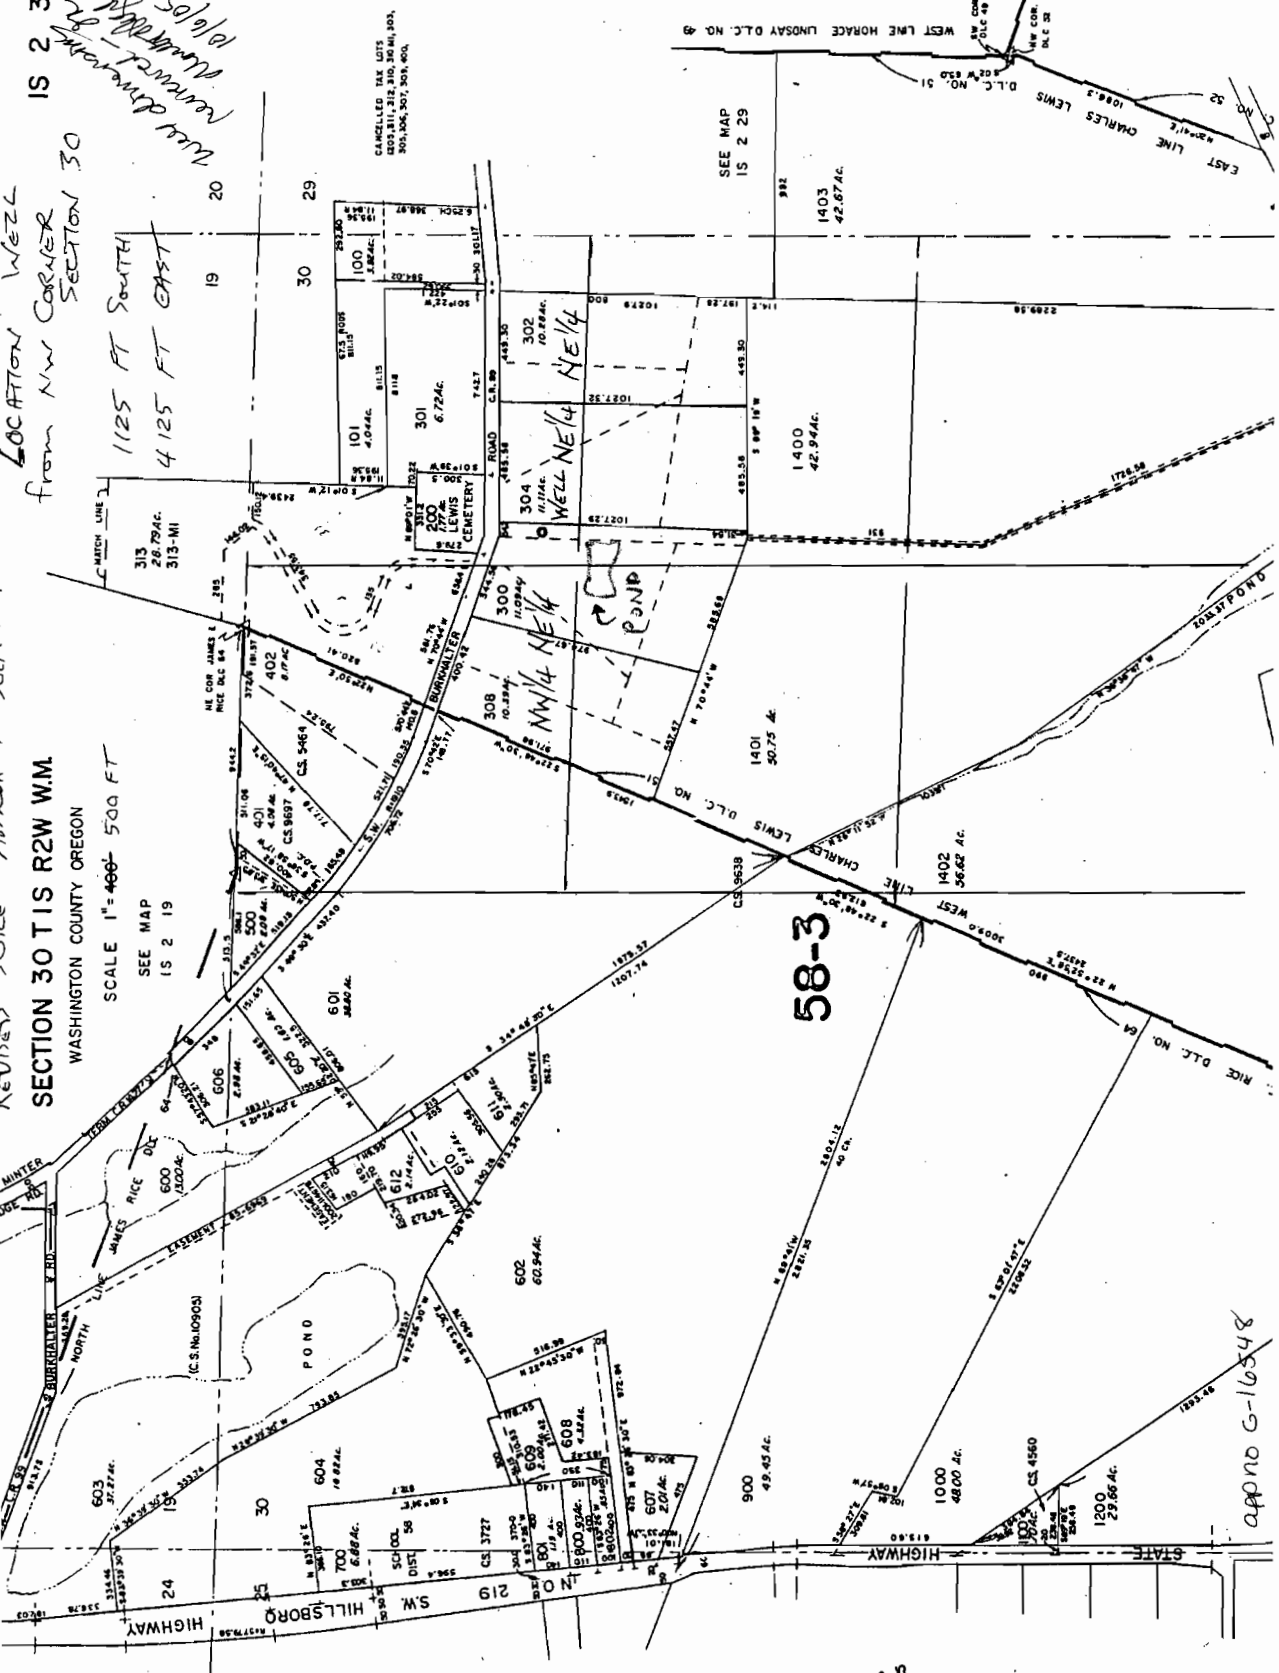

58-3

apno G-16548