


Amended  
10-4-2006  
Stan Herr

APPLICATION MAP FOR WATER RIGHTS


Stan Herr  
T.7S.,R.2W.,W.M.

RECEIVED

OCT 05 2006  
WATER RESOURCES DEPT  
SALEM, OREGON

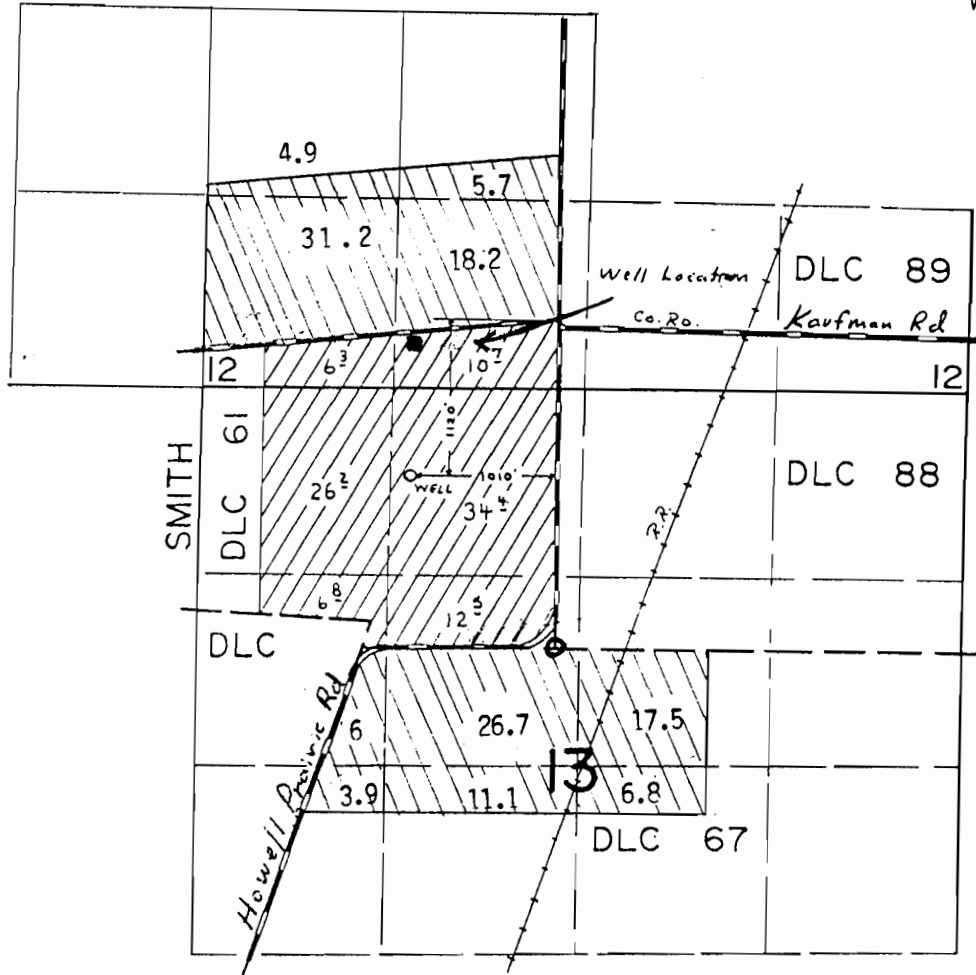

scale 1" = 1320'

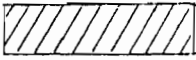96.9 Acres  Lands irrigated under Permit G-5436  
Requesting additional water to make up deficiency in rate

132 Acres  Lands requesting water under new permit from well

⊕ SE Corner of DLC 61

Propose Well Location - 2130' N & 1060' W From SE Corner DLC 61

Appno G-16539 Permit no G-16144

DFN-6LL-208