

G-16156

C-Canal

WORK COPY


405 10E

Total: 56.65

C-6
Diversion X

POU - Irrigation - 470' E from NE corner S7
50' S from NE corner S7

RECEIVED
FEB 16 2007

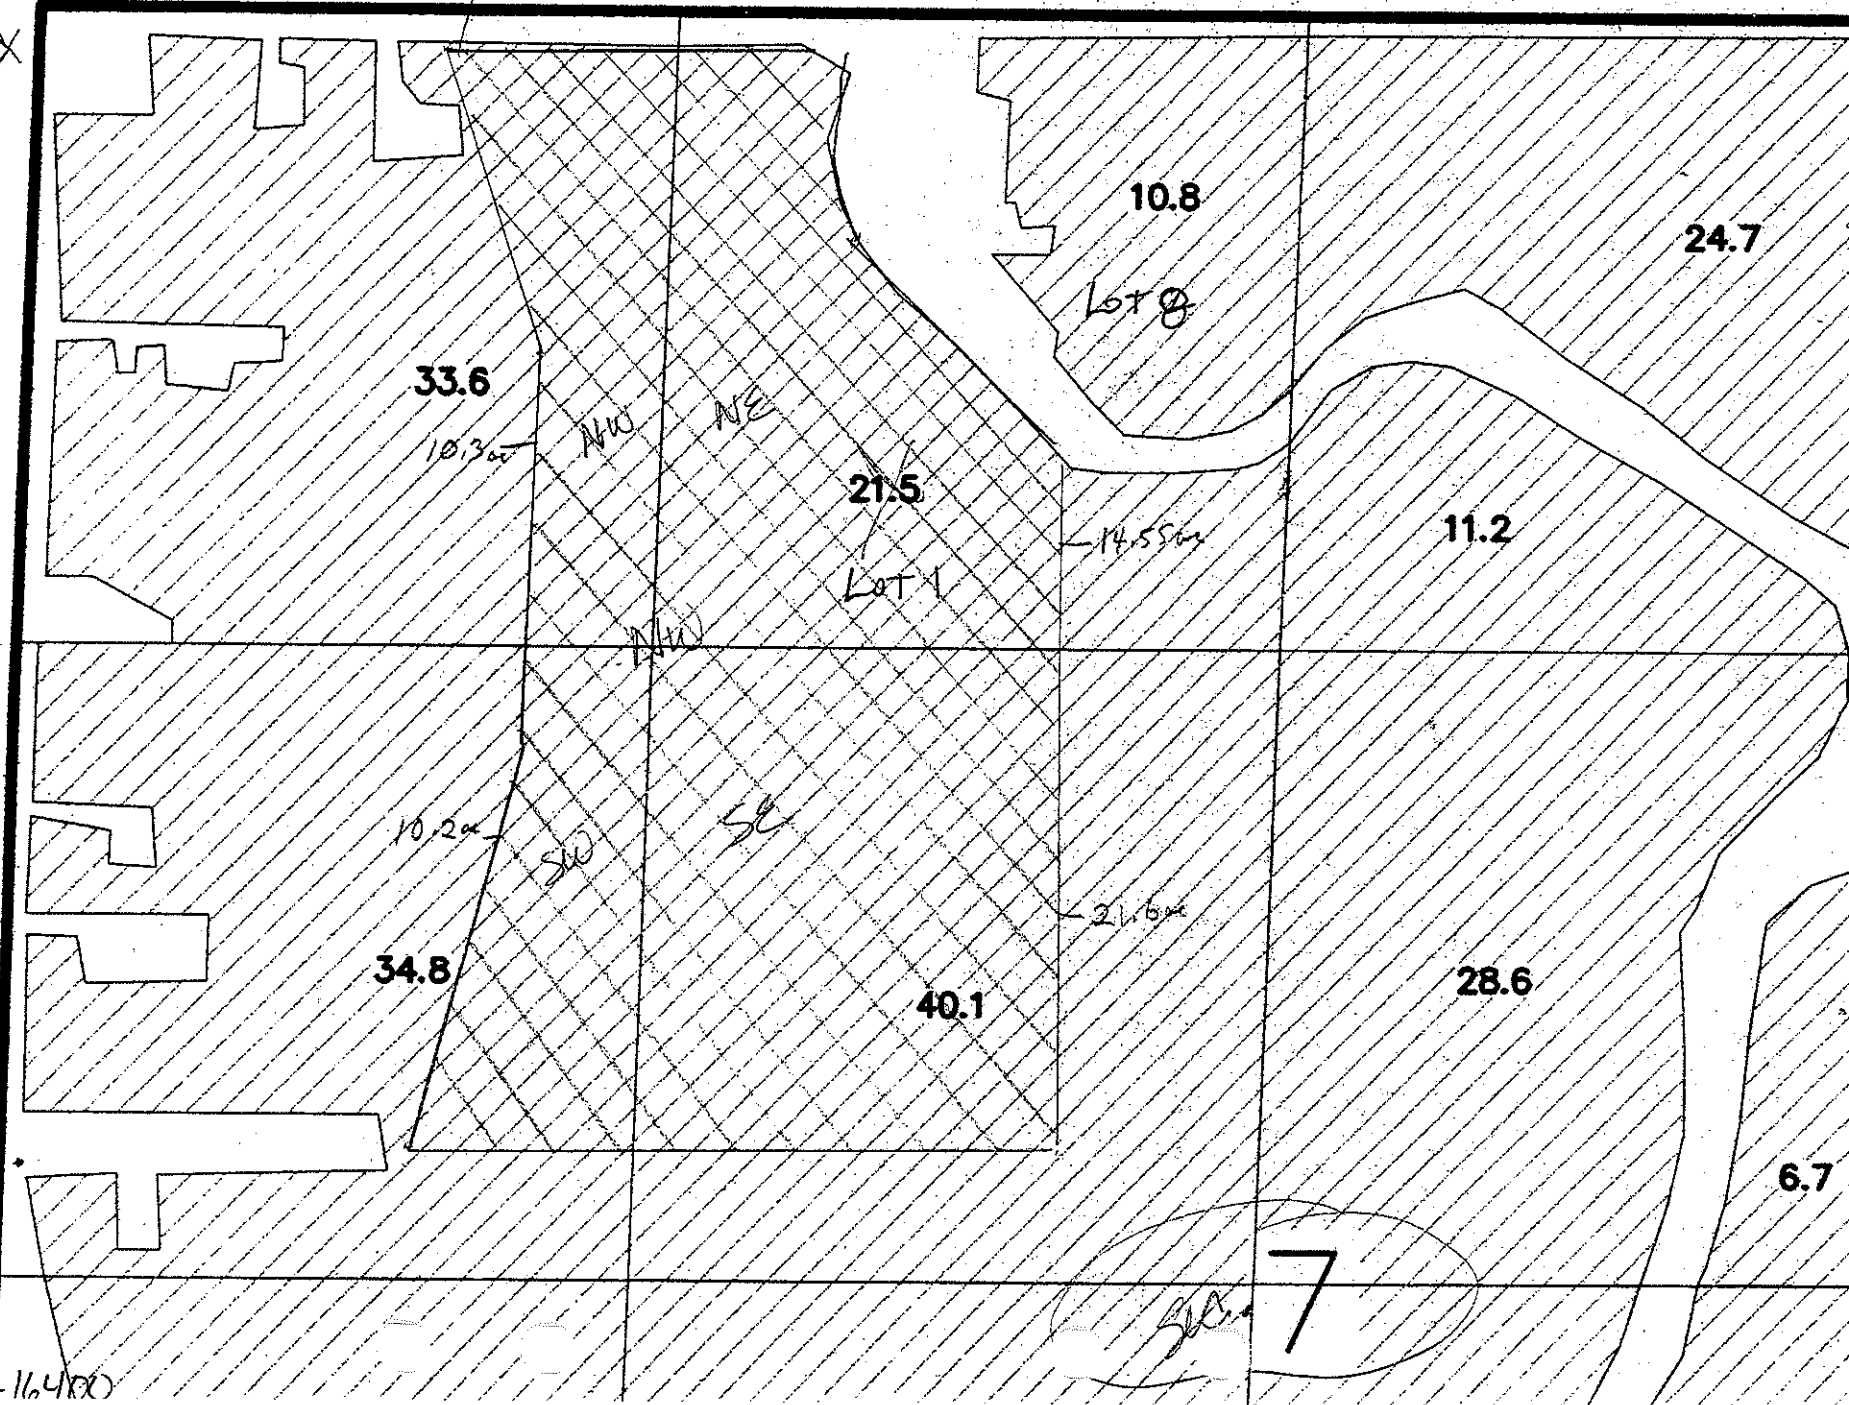

ATCH TO SHEET 21

APPEND (16400)

work copy

415 11E

Total: 81.5

sec 11

sw/sw

7.2 ac

16.8

19.6

19.2

LOT 4

LOT 3

39

NW/NW

34.1 NE/NW

12.2

14.5

14.2

5.6

5.6

sw/nw

se/nw

39.6


40.4

38.5

sec 14
E-5

LOT 6

WORK COPY

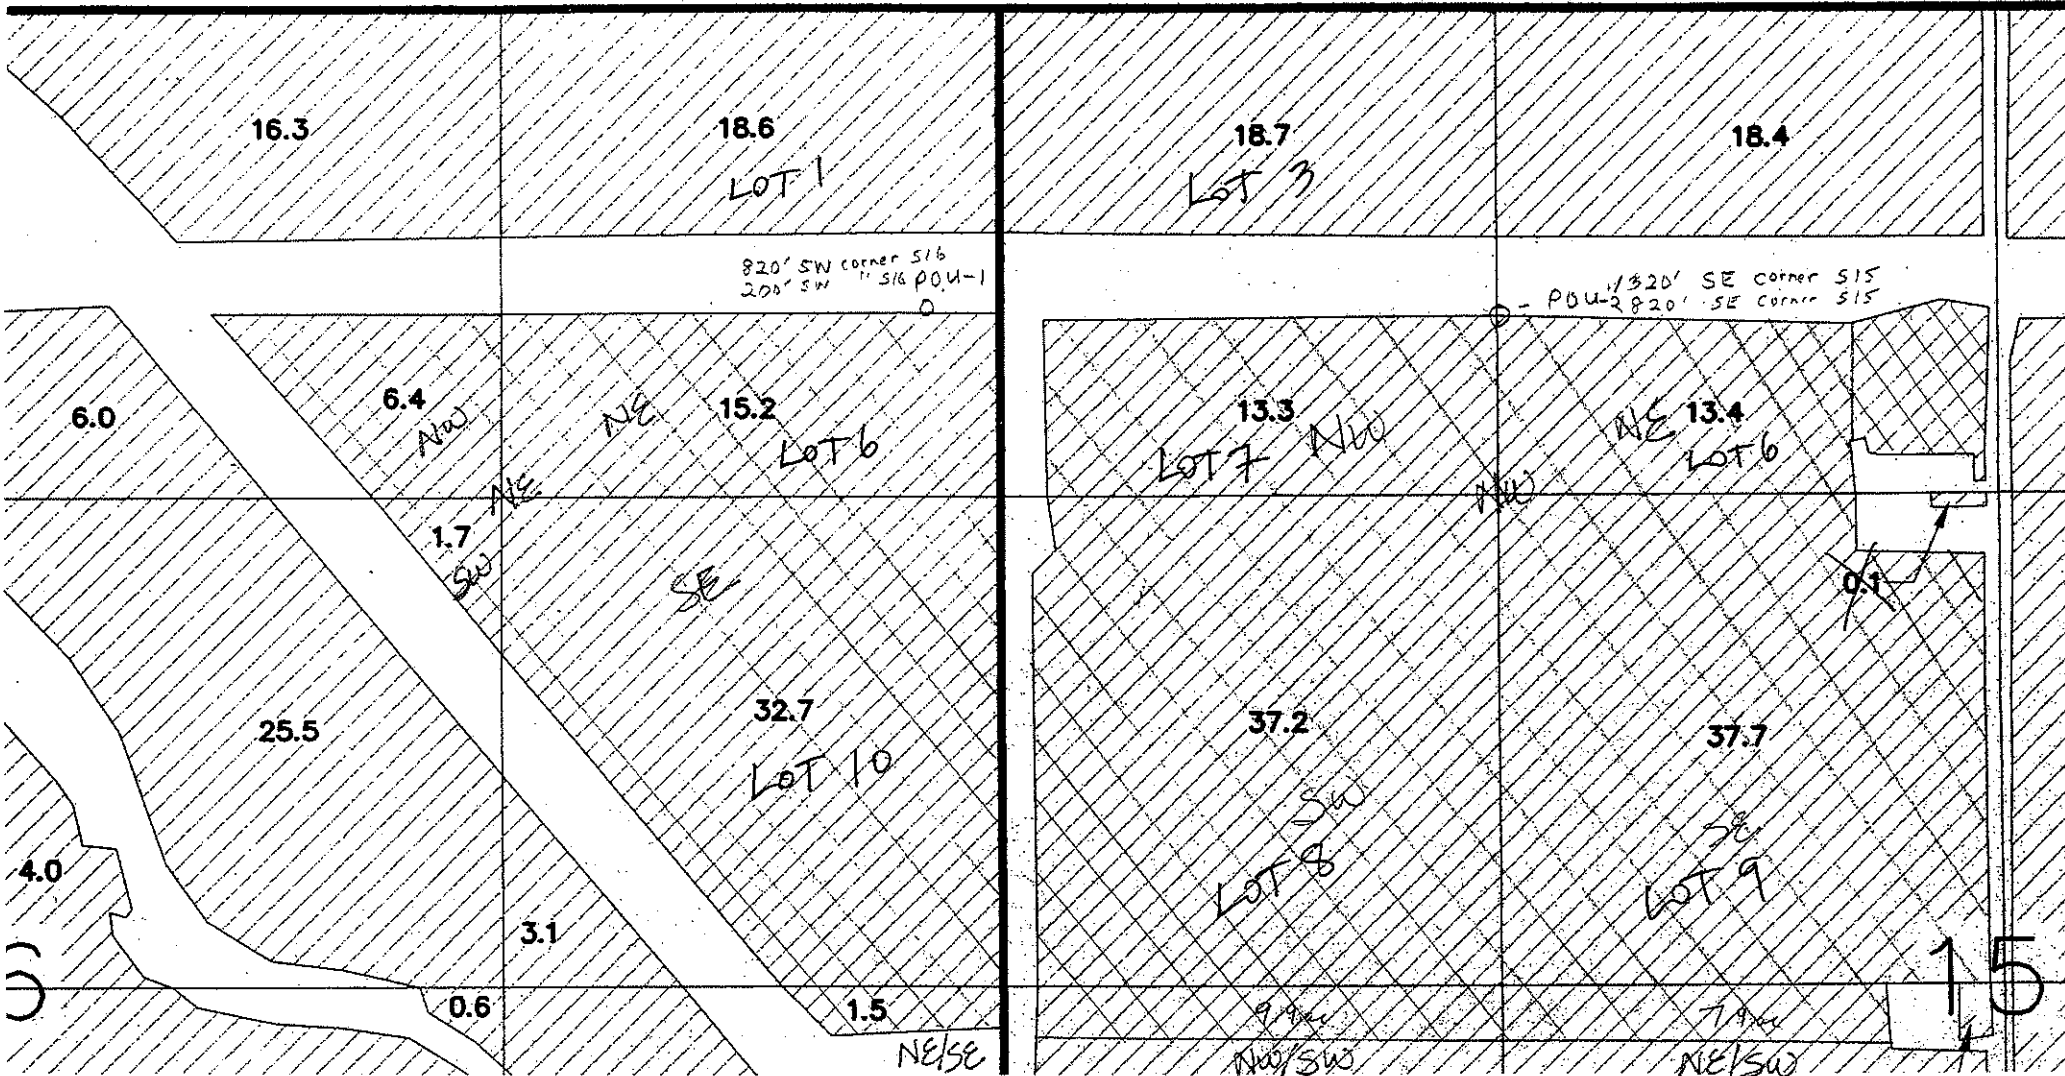

↑
Sec. 16

41 S 11 E

↑
Sec. 15

Total: 176.9

appno G-16400