


CDDMD 6-161694

RECEIVED
 JUL 10 2006
 WATER RESOURCES DEPT
 SALEM, OREGON

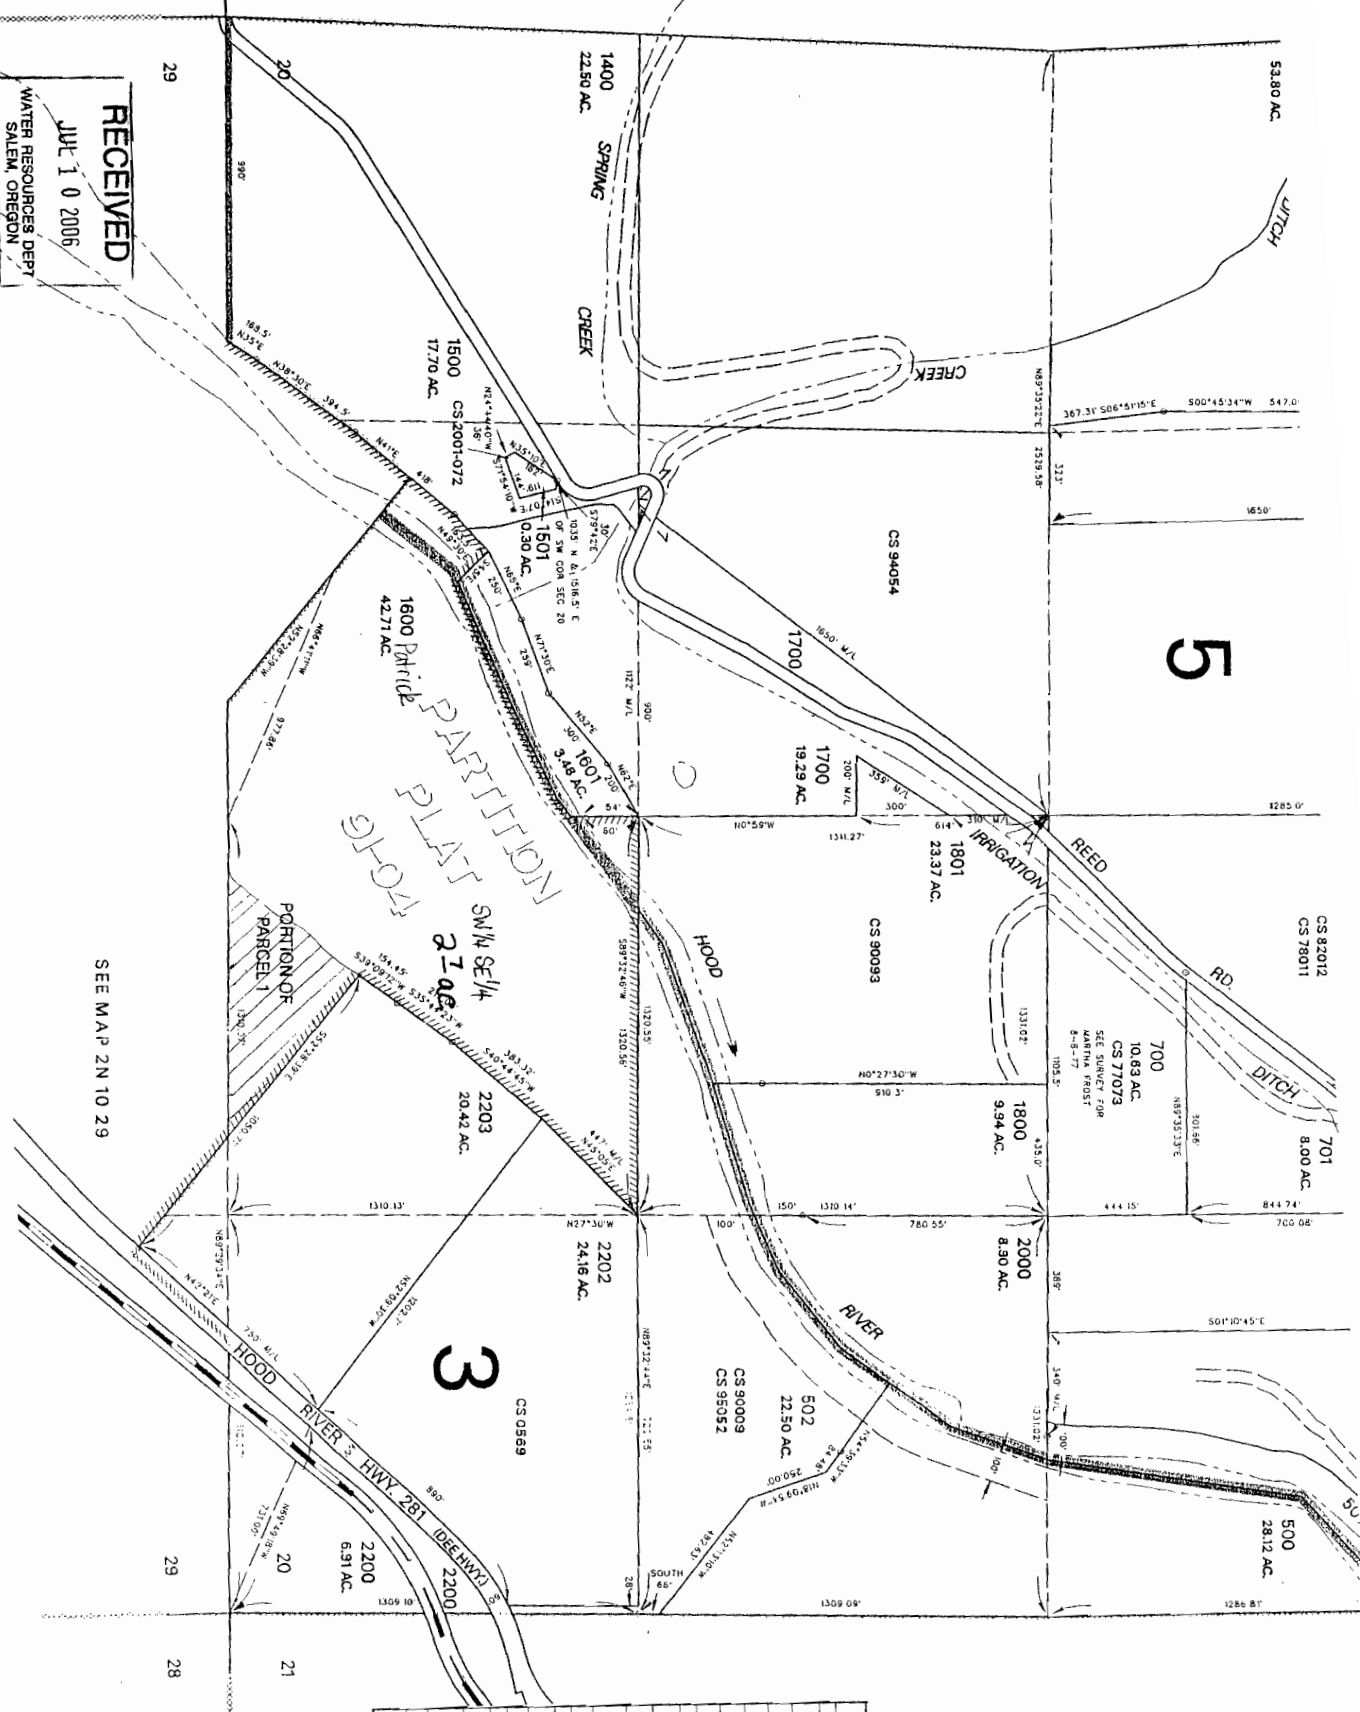


SEE MAP 2N 10 29

SEE MAP 2N 10 21

Map Legend
Map Symbols
Well Site
Open Ditch
Turnout Box
Property Lines
Proposed Supplemental Well Water Rights
Laurel Patrick
Hood River, Oregon
Section 2N-10-20 TL 1600
Scale 1" = 400' CMS

REVISID:
 11/19/02
 2N 10

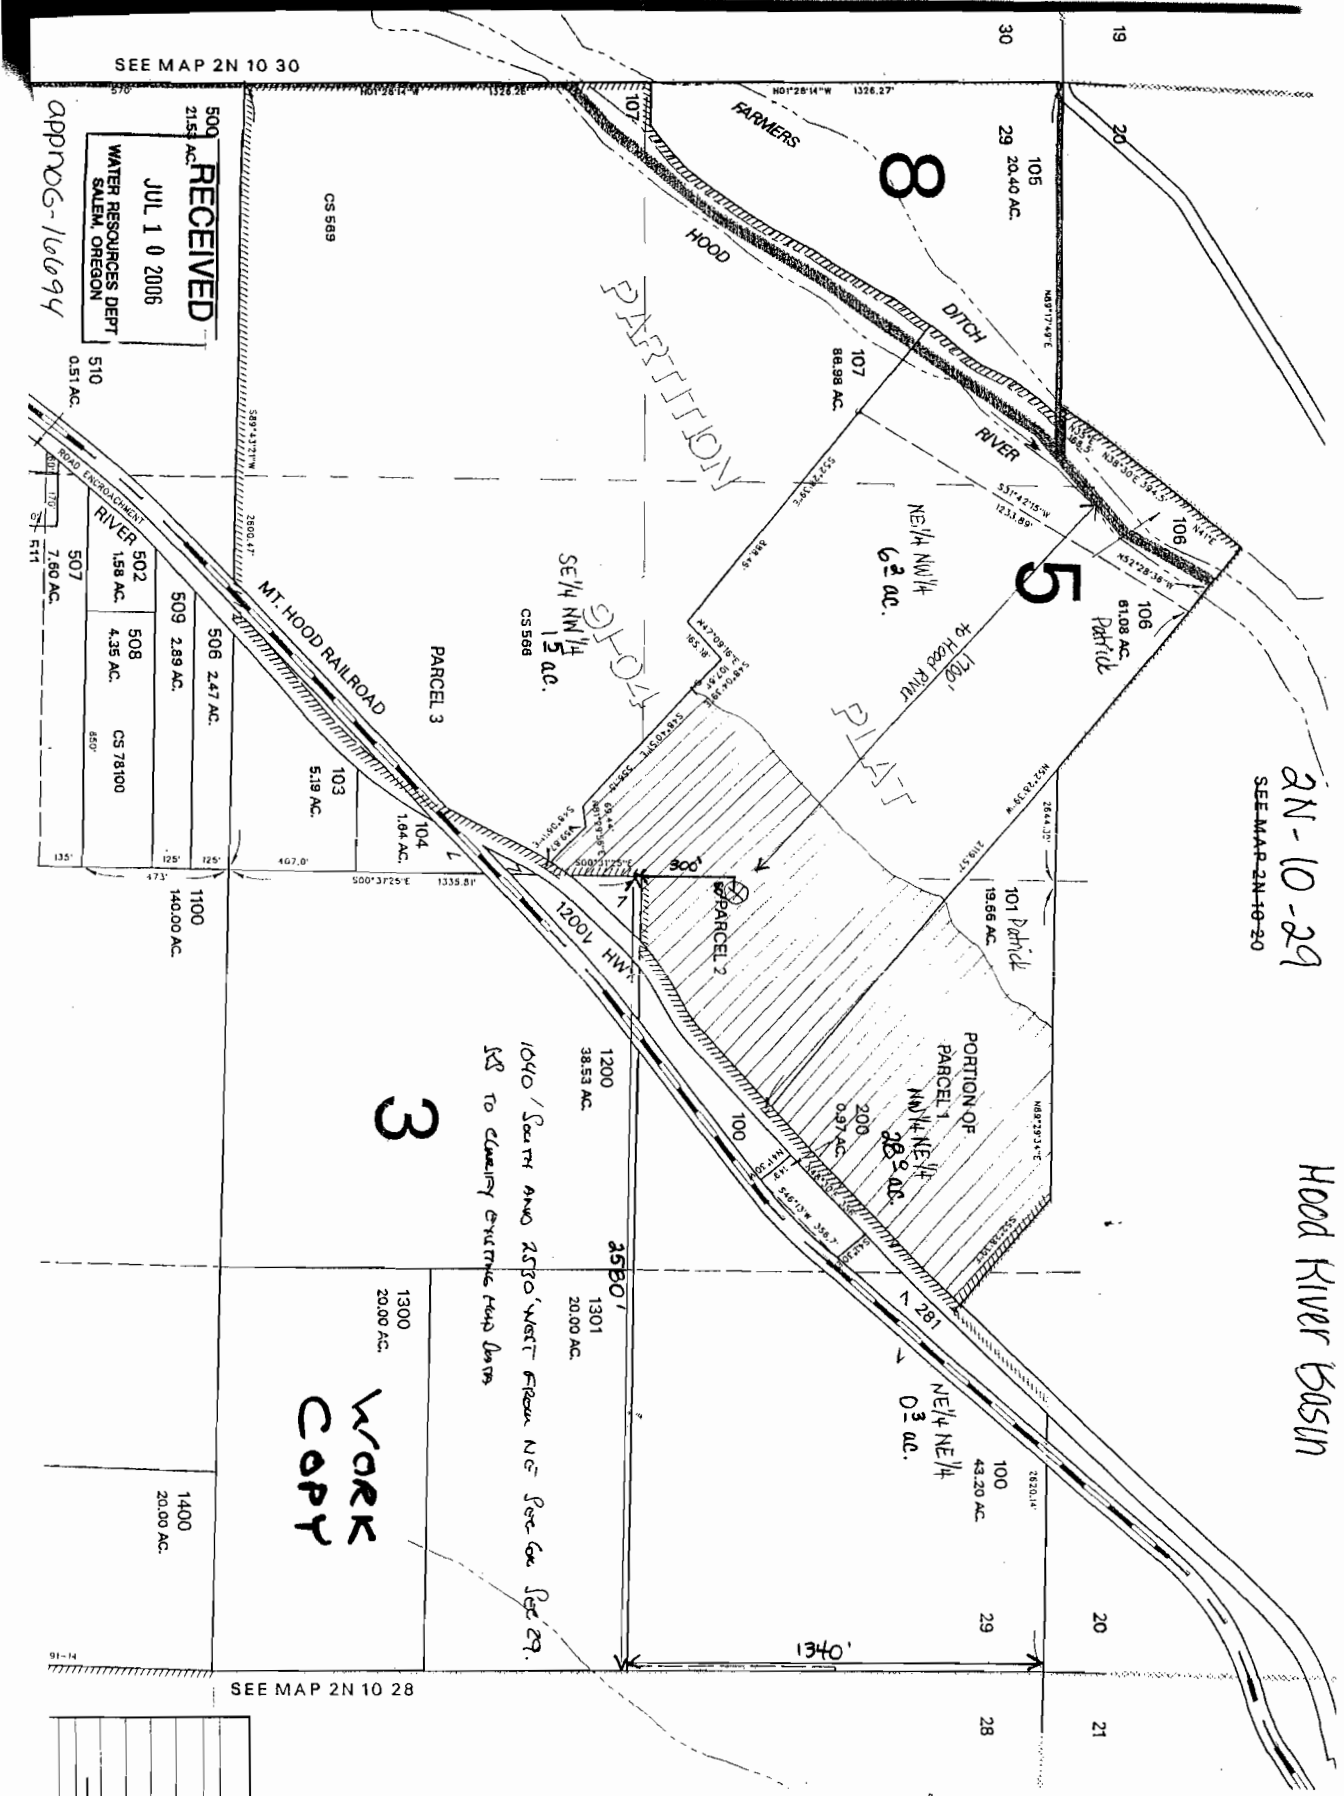

RECEIVED
 JUL 10 2006
 WATER RESOURCES DEPT
 SALEM, OREGON
 APPROX-16694

2N-10-29
 SEE MAP 2N-10-20

Hood River Basin


WORK COPY

Map Legend

Map Symbols	Well Site
Open Ditch	Turnout Box
Property Lines	

CAN
 102
 300
 400