


KLAMATH IRRIGATION DISTRICT KLAMATH RIVER ADJUDICATION CLAIMS MAP INDEX

RECEIVED
JUN 04 2003
WATER RESOURCES DEPT
SALEM, OREGON

Well: Map 11-6-32
SWSW, Sec 27, T39S/R10E
wm

App No G-16030 Permit No G-16209

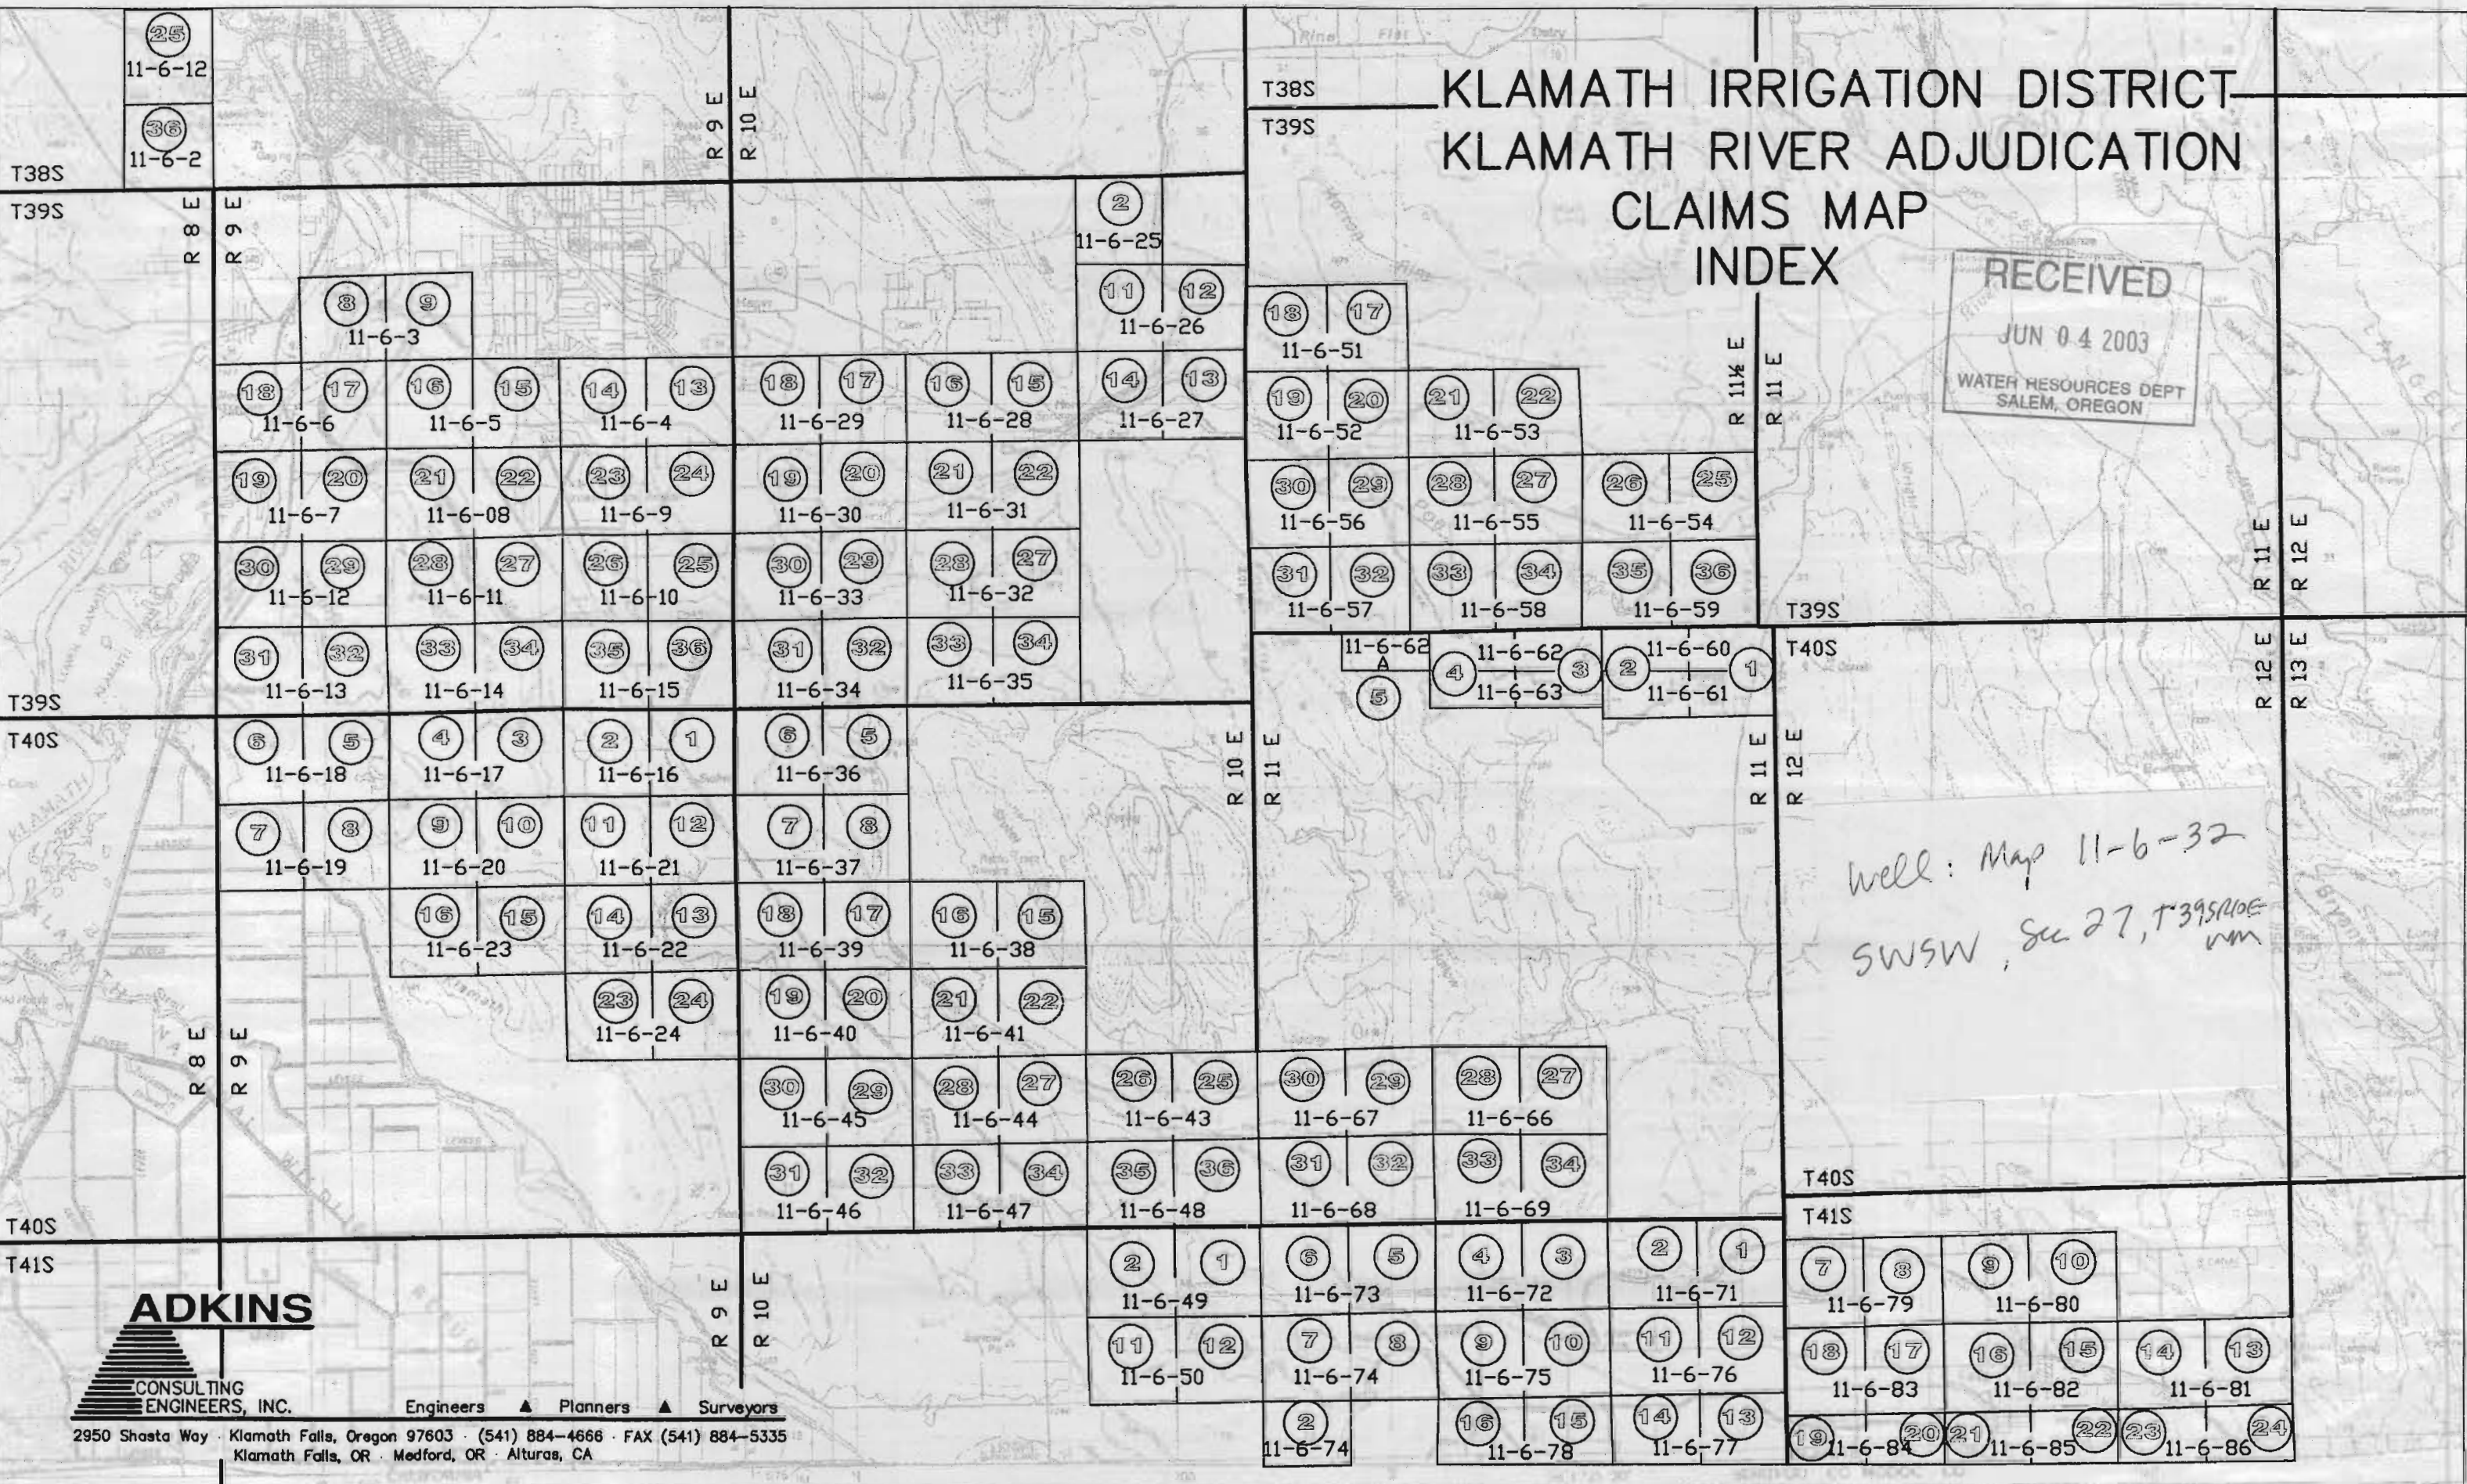

ADKINS
CONSULTING ENGINEERS, INC. Engineers ▲ Planners ▲ Surveyors
2950 Shasta Way · Klamath Falls, Oregon 97603 · (541) 884-4666 · FAX (541) 884-5335
Klamath Falls, OR · Medford, OR · Alturas, CA