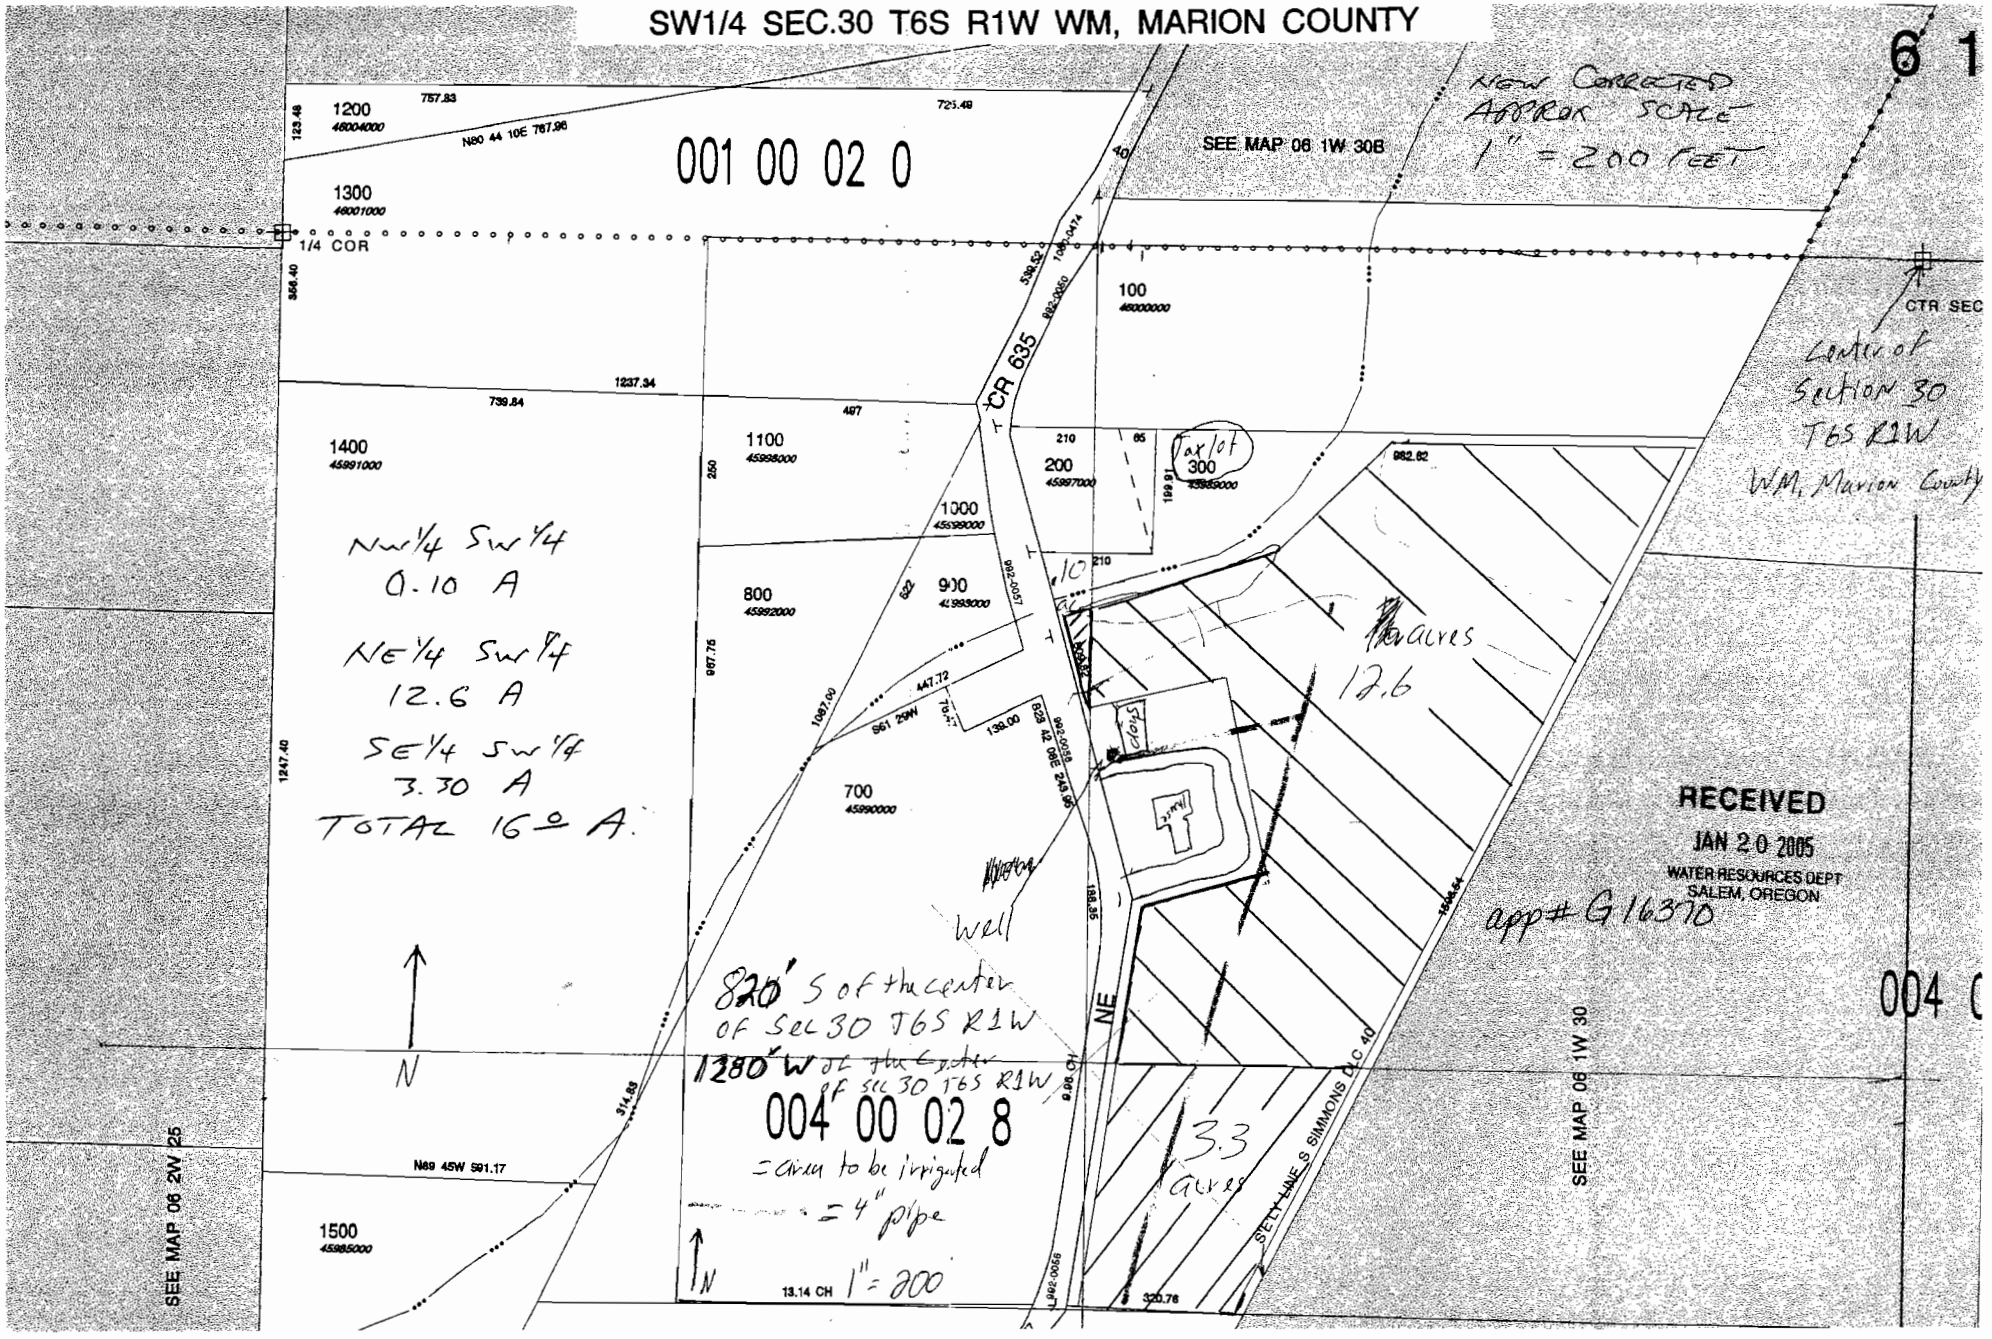
SW1/4 SEC.30 T6S R1W WM, MARION COUNTY
6 1
NEW CORRECTED APPROX SCALE 1" = 200 FEET
001 00 02 0
SEE MAP 06 1W 30B
1200
46004000
1300
46001000
1/4 COR
100
46000000
CTR SEC
Center of Section 30 T6S R1W WM, Marion County
CR 635
1400
45991000
1100
45998000
200
45997000
Tax lot
300
1000
45999000
800
45992000
900
45993000
700
45990000
Nw1/4 Sw1/4
0.10 A
NE1/4 Sw1/4
12.6 A
SE1/4 Sw1/4
3.30 A
TOTAL 16.0 A.
12.6
acres
RECEIVED
JAN 20 2005
WATER RESOURCES DEPT
SALEM, OREGON
app# G16370
Well
820' S of the center of Sec 30 T6S R1W
1280' W of the center of Sec 30 T6S R1W
004 00 02 8
= area to be irrigated
= 4" pipe
1" = 200
N
NE
3.3 acres
SELY LINE S SIMMONS DLC 40
SEE MAP 06 1W 30
004 0
SEE MAP 06 2W 25
1500
45985000
N89 45W 591.17
13.14 CH
320.76