T25S, R30E, Wm

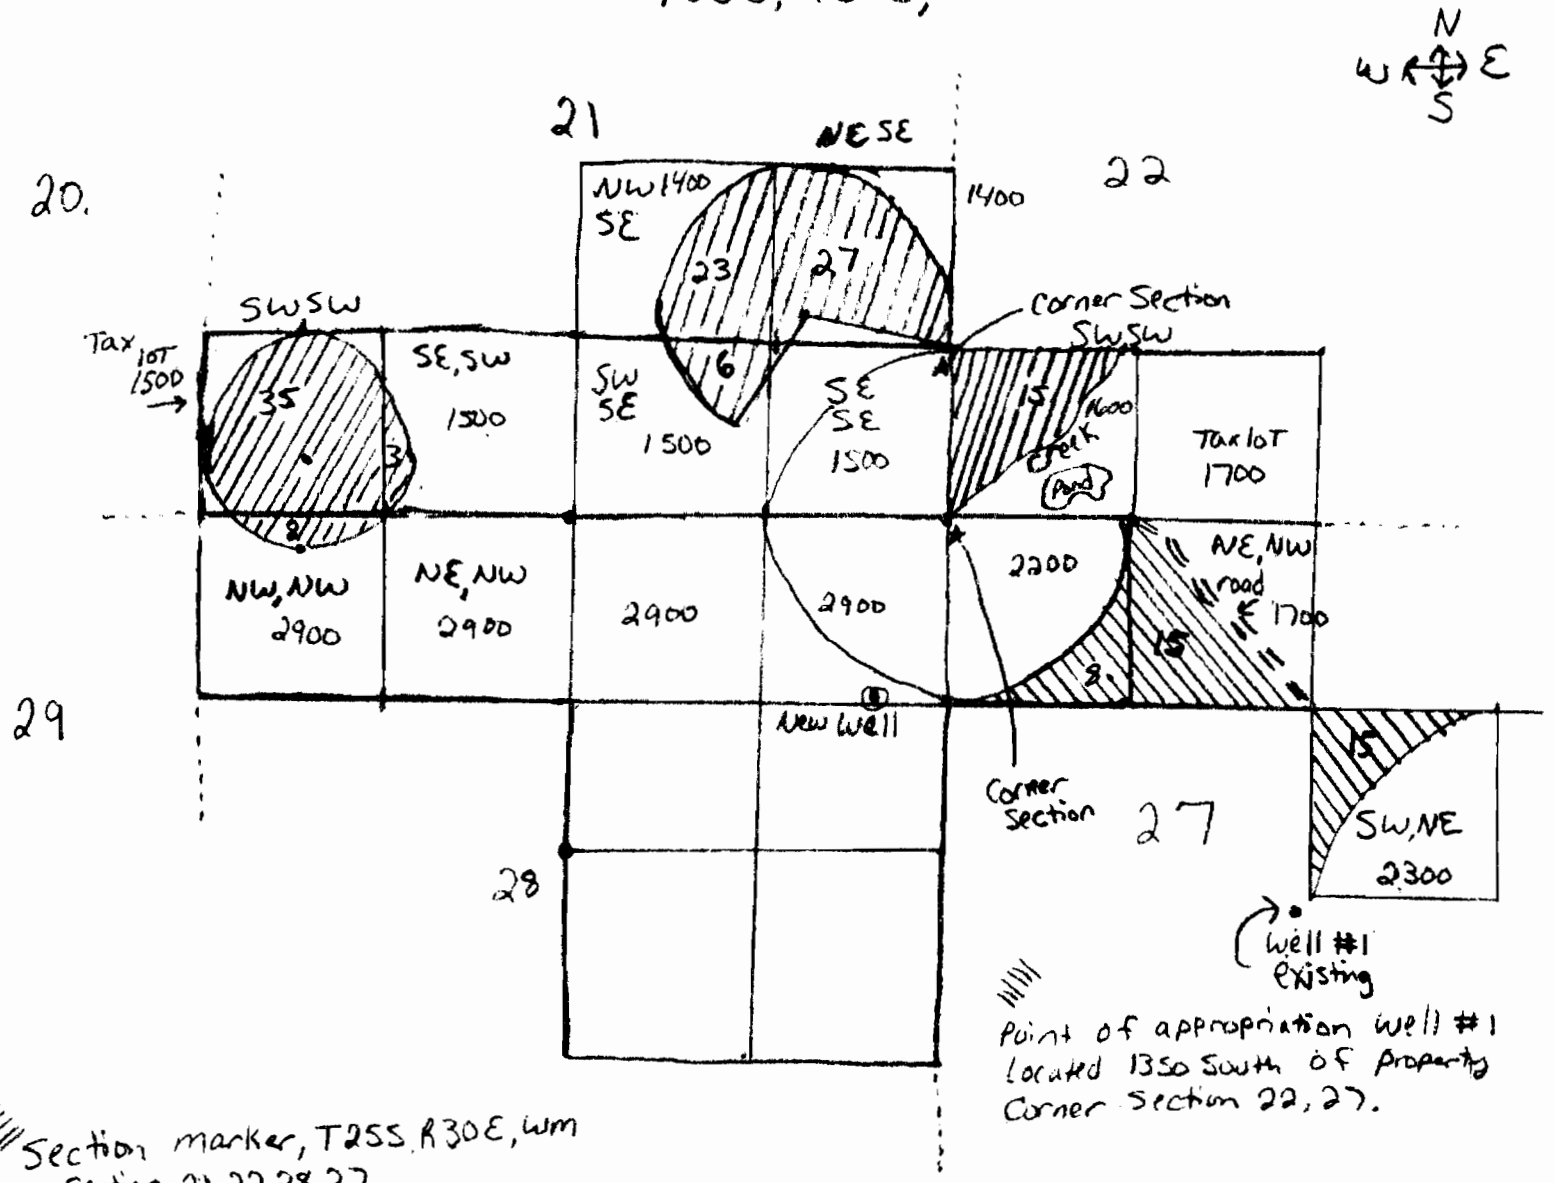

Point of appropriation well #1 located 1350 South of Property Corner Section 22, 27.

Section marker, T25S, R30E, Wm
Section, 21, 22, 28, 27

Point of Appropriation, well (new) # L83522
located, 1486' South, and 200' West from the Section marker 21, 22, 28, 27

Place of use

Sec.			
21	SW	SW	35 acres
21	SE	SW	3 acres
28	NW	NW	8 acres
21	NW	SE	23 acres
21	SW	SE	6 acres
21	NE	SE	27 acres
22	SW	SW	15 acres
27	NE,	NW	15 acres
27	SW,	NE	15 acres
27	NE,	NW	8 acres
		Total	155 acres

WATER RIGHT APPLICATION

Scale 4" = 1 mile

⊙ = well Site

//// = Proposed area to be irrigated

|| = Road Driveway

~ = Creek (Dry)

✱ = Corner section marker

RECEIVED
APR 14 2006
WATER RESOURCES DEPT
SALEM, OREGON

G-16670