


WORK
COPY

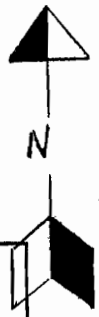

app no. G 16317
T.13S. R.40E. W.M.
MALHEUR COUNTY

1" = 1000'
SCALE @
APPROX. 1" = 1000 FT.

RECEIVED
SEP 22 2004
WATER RESOURCES DEPT
SALEM, OREGON



--- under ground pipe line

-  PRIMARY
-  SUPPLEMENTAL

WELL is located
2,442' N & 2,080' W
FROM SE CORNER OF SEC 27

