


TWP 37 S R6WWM

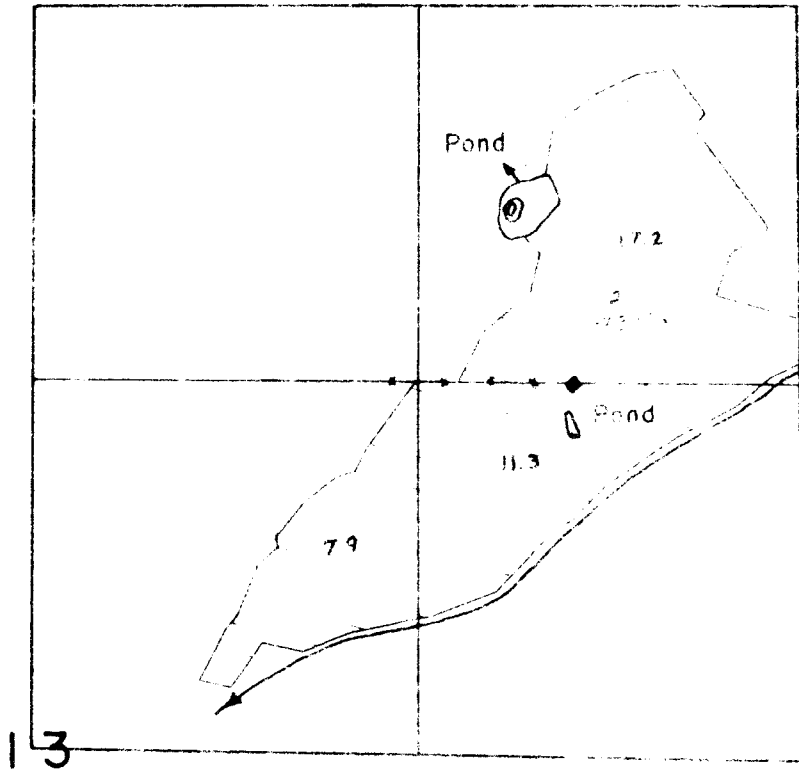

NE 1/4 SEC. 13

Scale 8"=1M'

DE 4 D...  
 16-...  
 10-...

FINAL PROOF SURVEY UNDER

Application No G-1776 Permit No. G-1624 IN NAME OF

Orie L Boyer

Surveyed 6-6 1963, by R Steimer