

RECEIVED

MAR 07 2005

WATER RESOURCES DEPT
SALEM, OREGON


GROUNDWATER APPLICATION FOR
JACK ROBINSON & SONS

TOWNSHIP 19 SOUTH RANGE 15 EAST
SECTION 30

RECEIVED

FEB 24 2005

WATER RESOURCES DEPT
SALEM, OREGON

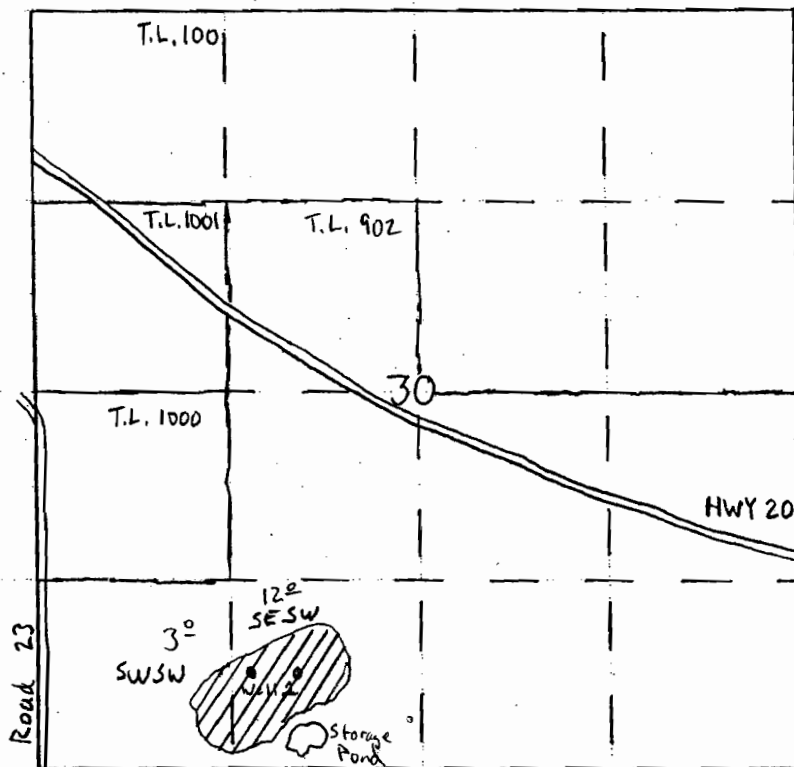

Well #1 = 1400' East & 600' North of the SW 1/4 of Section 30,
Township 19 South Range 15 East, W.M.

▨ = Industrial P.O.U.

app # G 16403