


SECTION PLAY

Section 10 & 15 Township 26-S Range 30-E

County of HARNEY State of OREGON

NORTH

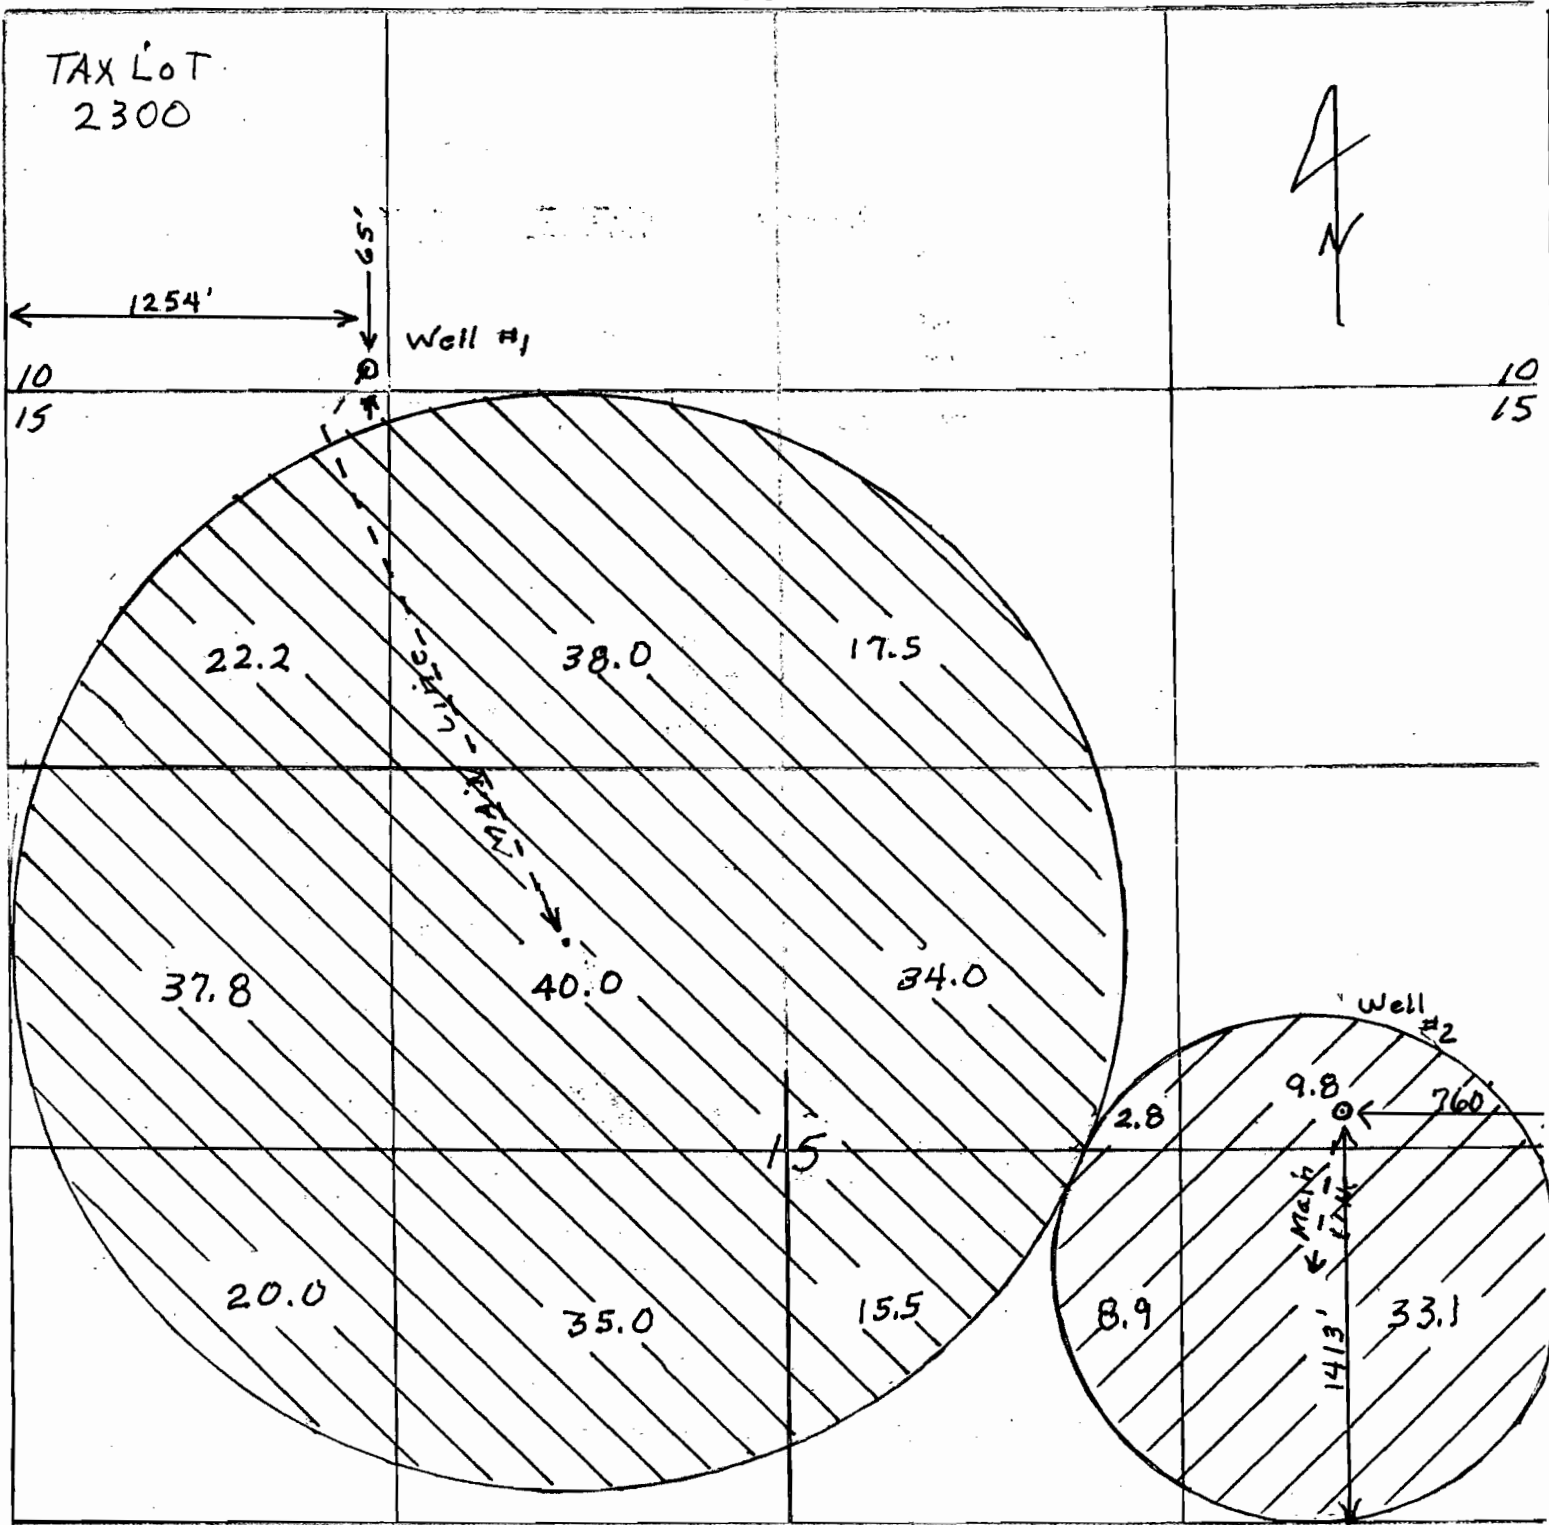

Remarks scale - 8" = 1 mile - 660' -

RECEIVED
JAN 19 2006
WASCO RECORDS DEPT
EMER. RECORDS

G-16599