


N

REGISTERED AND  
 LICENSED  
 SURVEYOR  
 W. E. GILLESPIE  
 6/27/60  
 MAY 1955  
 W. E. GILLESPIE  
 344

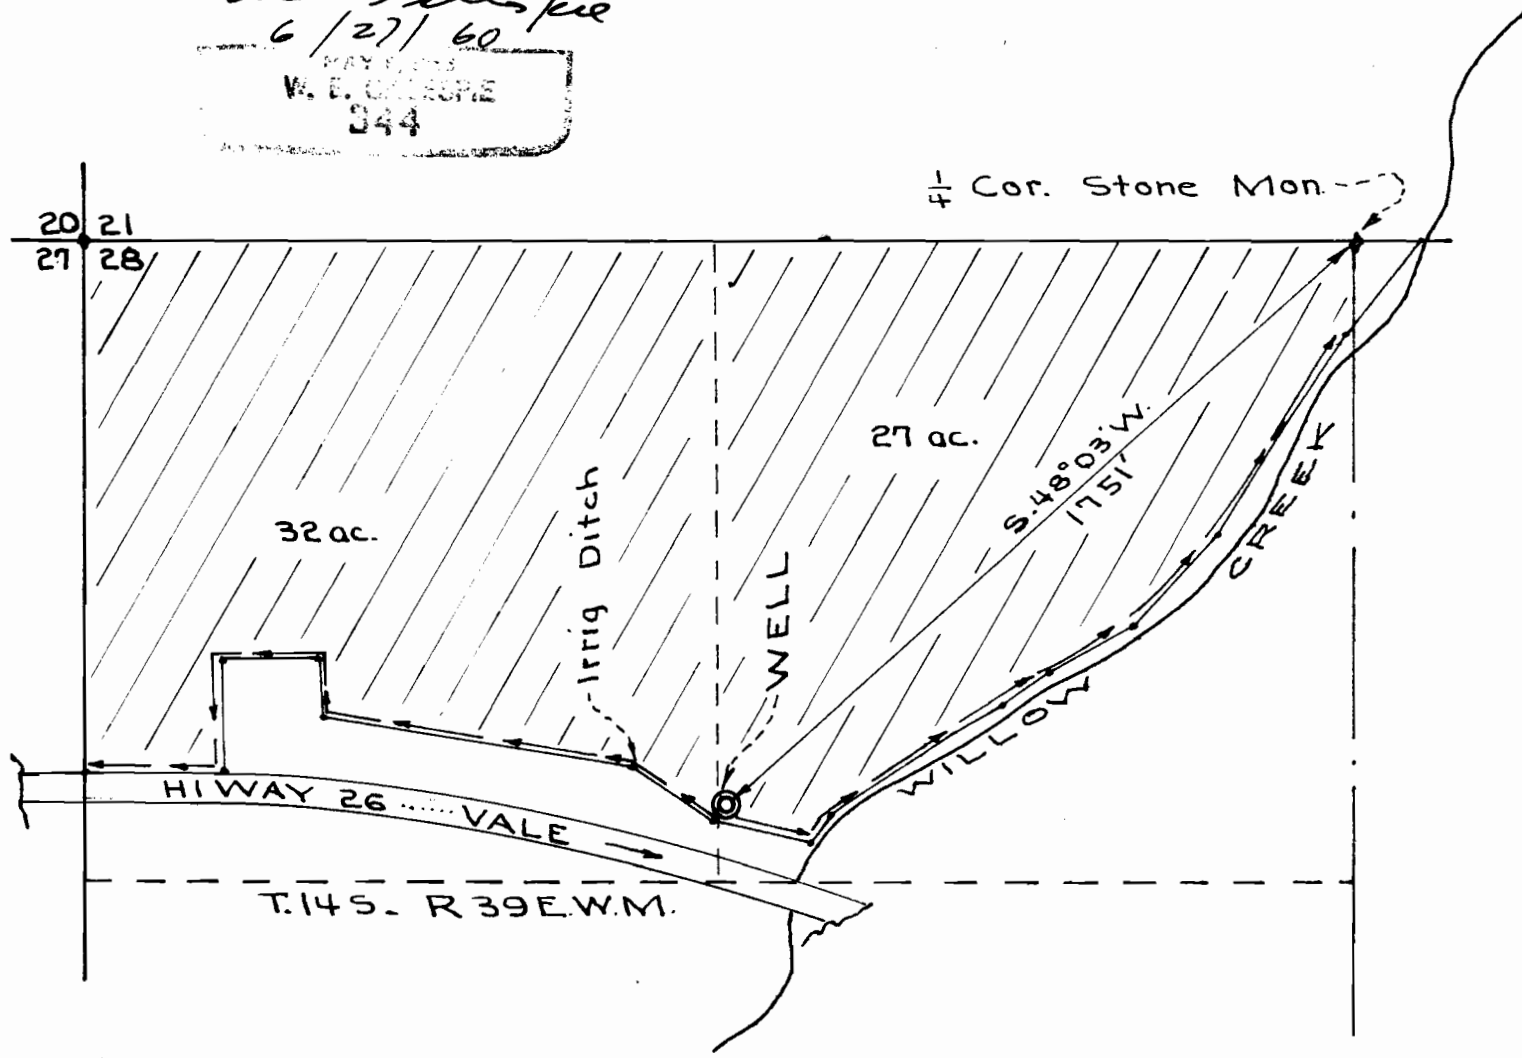

APPLICATION FOR PERMIT  
 Oakes & Ogilvie-Ironside, Ore.

Scale 1" = 400'

Application No. G-1780  
 Permit No. G-1626