was prepared for
ent purposes only.

2/11/03

SW1/4 SEC 34 T5N R28E WM
UMATILLA COUNTY, OR

SCALE: 1" = 200

Aerial Photo

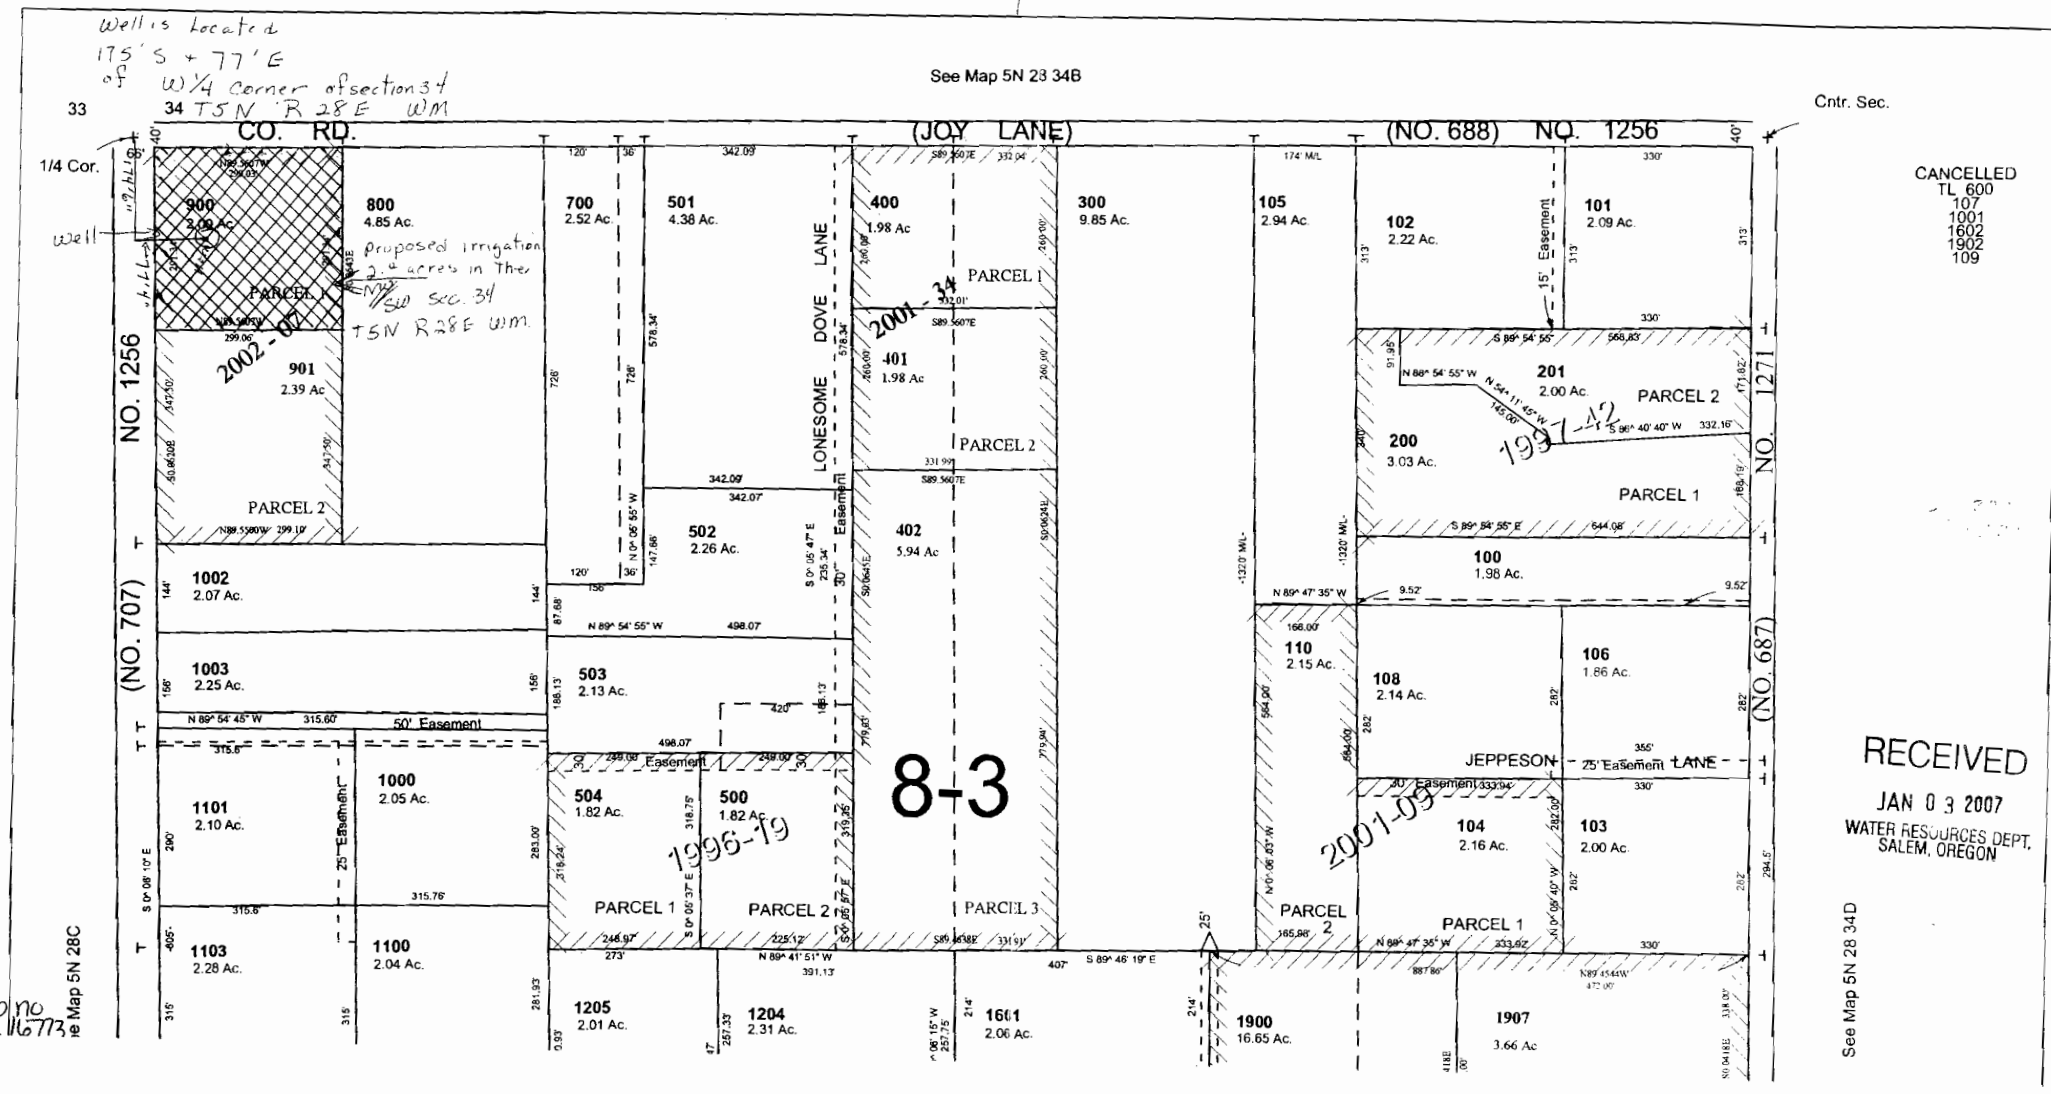

RECEIVED
JAN 03 2007
WATER RESOURCES DEPT.
SALEM, OREGON

app no
116773