

LEGEND

LINE TYPES

AX LOT BOUNDARY	OLD PROPERTY LINE
DAD RIGHT-OF-WAY	VACATED RIGHT-OF-WAY
JULROAD	RAILROAD RIGHT-OF-WAY
STREAM, LAKE, ETC.	STREAM, LAKE, ETC.
AX LOT BOUNDARY	NON-BOUNDARY
SUBDIVISION BOUNDARY	PARTITION PLAT Bdy.
AX CODE BOUNDARY	EASEMENT

SYMBOL TYPES


DLC	
CONTROL POINTS	
SURVEY MONUMENTS	
C.O.G. CORNERS	
SECTION	
1/4 SEC	1/4 SEC
1/4 COR	1/4 COR

NUMBERS

TAX CODE NO
000 00 00 0

ACREAGE - ALL ACREAGES EXCLUDE ANY PORTION THAT MAY LIE WITHIN THE INDICATED PUBLIC RIGHT OF WAYS.

TICK MARKS - WHEN A TICK MARK IS INDICATED ON THE EXTENSION OF A LINE, THEN THE DIMENSION GOES TO THE TICK MARK. GENERALLY THIS IS USED WHEN DIMENSIONS GO INTO PUBLIC RIGHT OF WAYS.

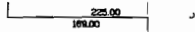

ARROWS ARE USED WITH DIMENSIONS IN AREAS OF GREATER COMPLEXITY.

NOTICE: This map was created for Assessor's Office use ONLY.



SCALE 1" = 200'
or 1:2400

File created: December 19, 1997


SW1/4 SEC.34 T7S R2W WM, MARION COUNTY

RECEIVED
FEB 08 2007
WATER RESOURCES DEPT
SALEM OREGON

SEE MAP 07 2W 34B

SEE MAP 07 2W 34BD

7 2W 34C

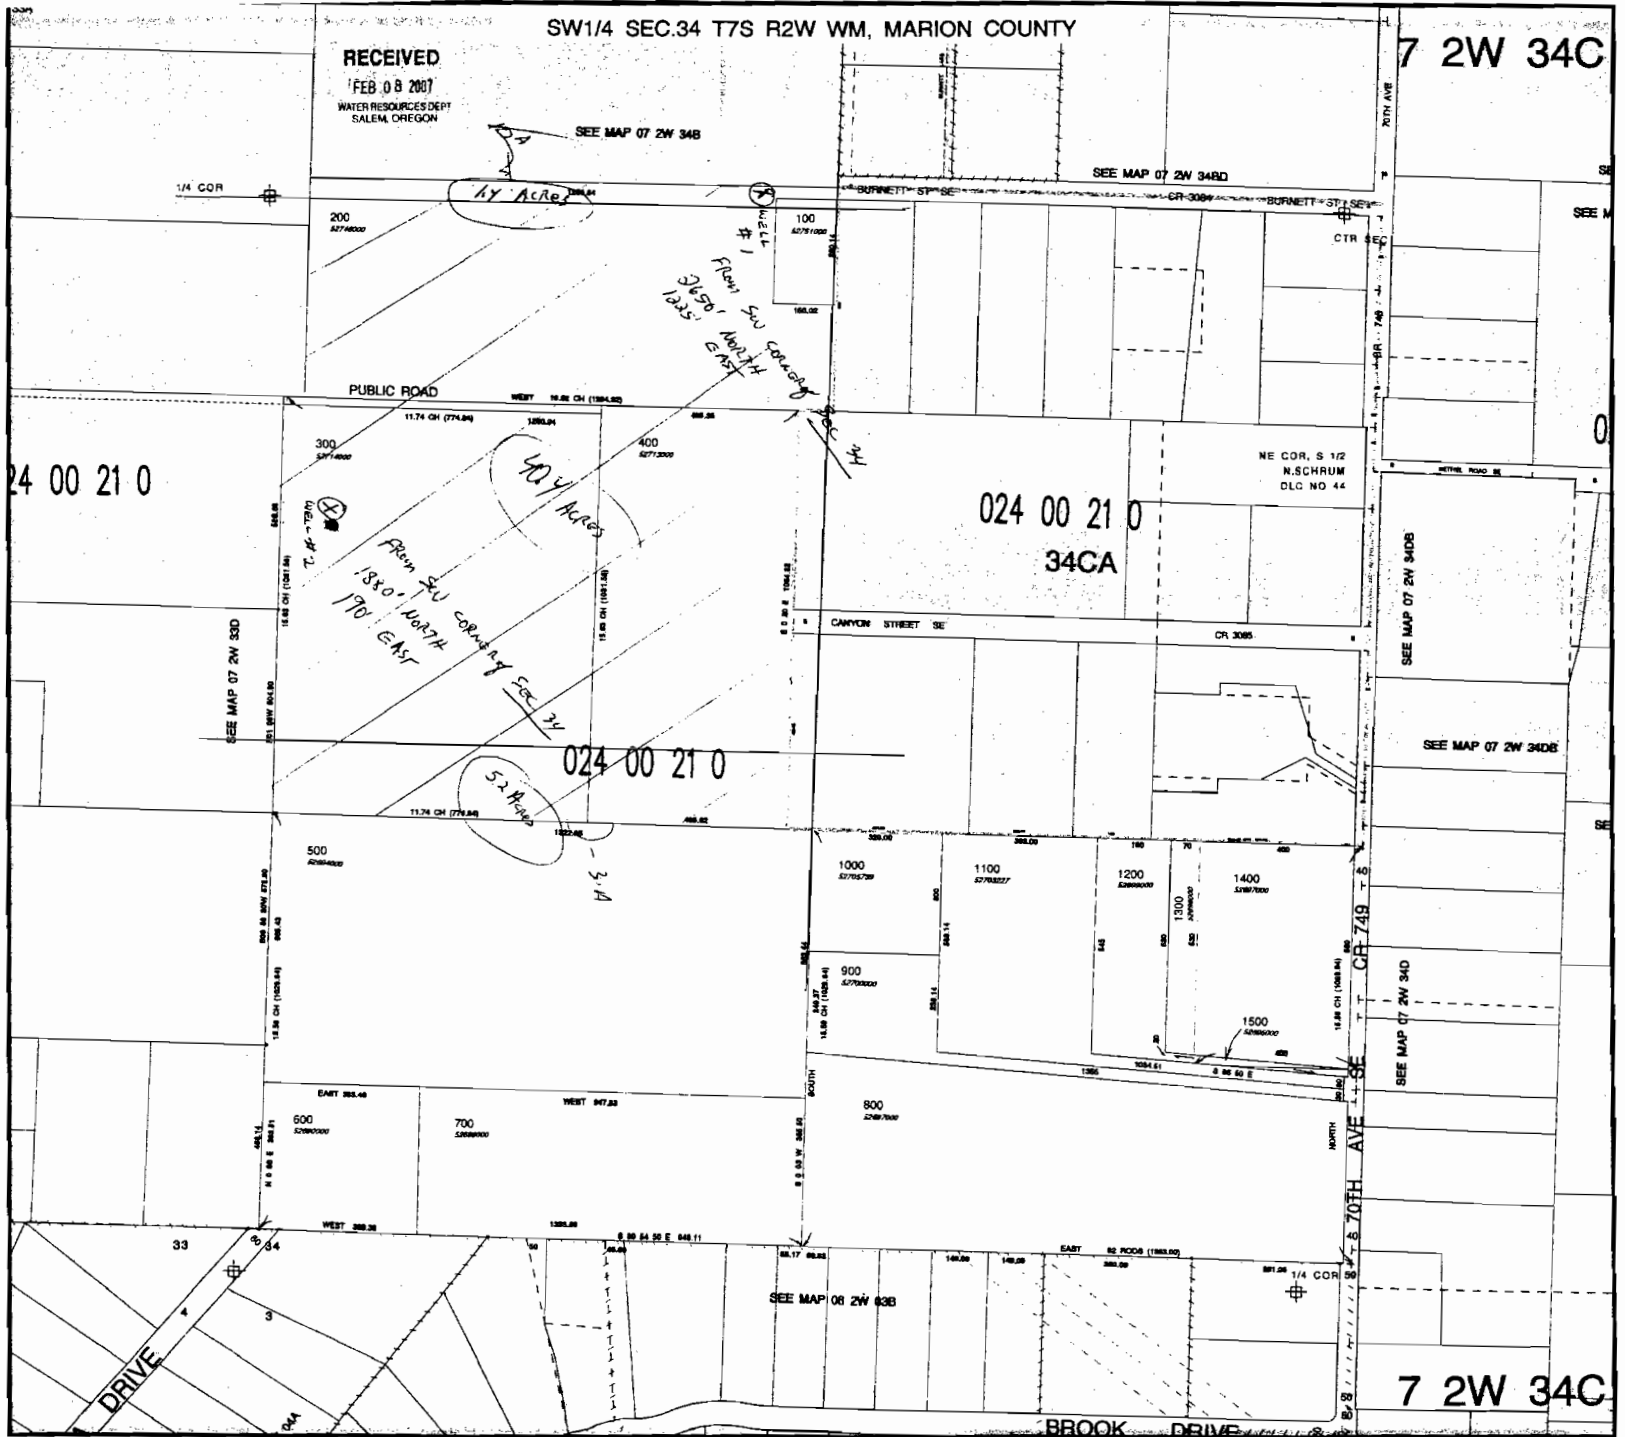

SEE MAP 07 2W 34BD

SEE MAP 07 2W 34DE

SEE MAP 07 2W 34D

7 2W 34C

reduced copy

SE1/4 SEC.33 T7S R2W WM, MARION COUNTY

7 2W 33D

LEGEND

LINE TYPES

- TAX LOT BOUNDARY OLD PROPERTY LINE
- ROAD RIGHT-OF-WAY VACATED RIGHT-OF-WAY
- ROAD RAILROAD RIGHT-OF-WAY
- STREAM, LAKE, ETC. TAX LOT BOUNDARY STREAM, LAKE, ETC. NON-BOUNDARY
- SUBDIVISION BOUNDARY PARTITION PLAT BOD.
- TAX CODE BOUNDARY EASEMENT

SYMBOL TYPES


- DLC
- CONTROL POINTS
- SURVEY MONUMENTS
- G.L.C. CORNERS
- SECTION 1/4 SEC 1/4 COR 1/16 SEC 1/16 COR

NUMBERS

TAX CODE NO.
000 00 00 0

ACREAGE - ALL ACREAGES EXCLUDE ANY PORTION THAT MAY LIE WITHIN THE INDICATED PUBLIC RIGHT OF WAYS.

TICK MARKS - WHEN A TICK MARK IS INDICATED ON THE EXTENSION OF A LINE, THEN THE DIMENSION GOES TO THE TICK MARK. GENERALLY THIS IS USED WHEN DIMENSIONS GO INTO PUBLIC RIGHT OF WAYS.

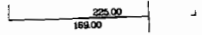

ARROWS ARE USED WITH DIMENSIONS IN AREAS OF GREATER COMPLEXITY.


NOTICE: This map was created for Assessor's Office use ONLY.



SCALE 1" = 200'
or 1:2400

dt file created: December 09, 1997

APPNO: 6-16792

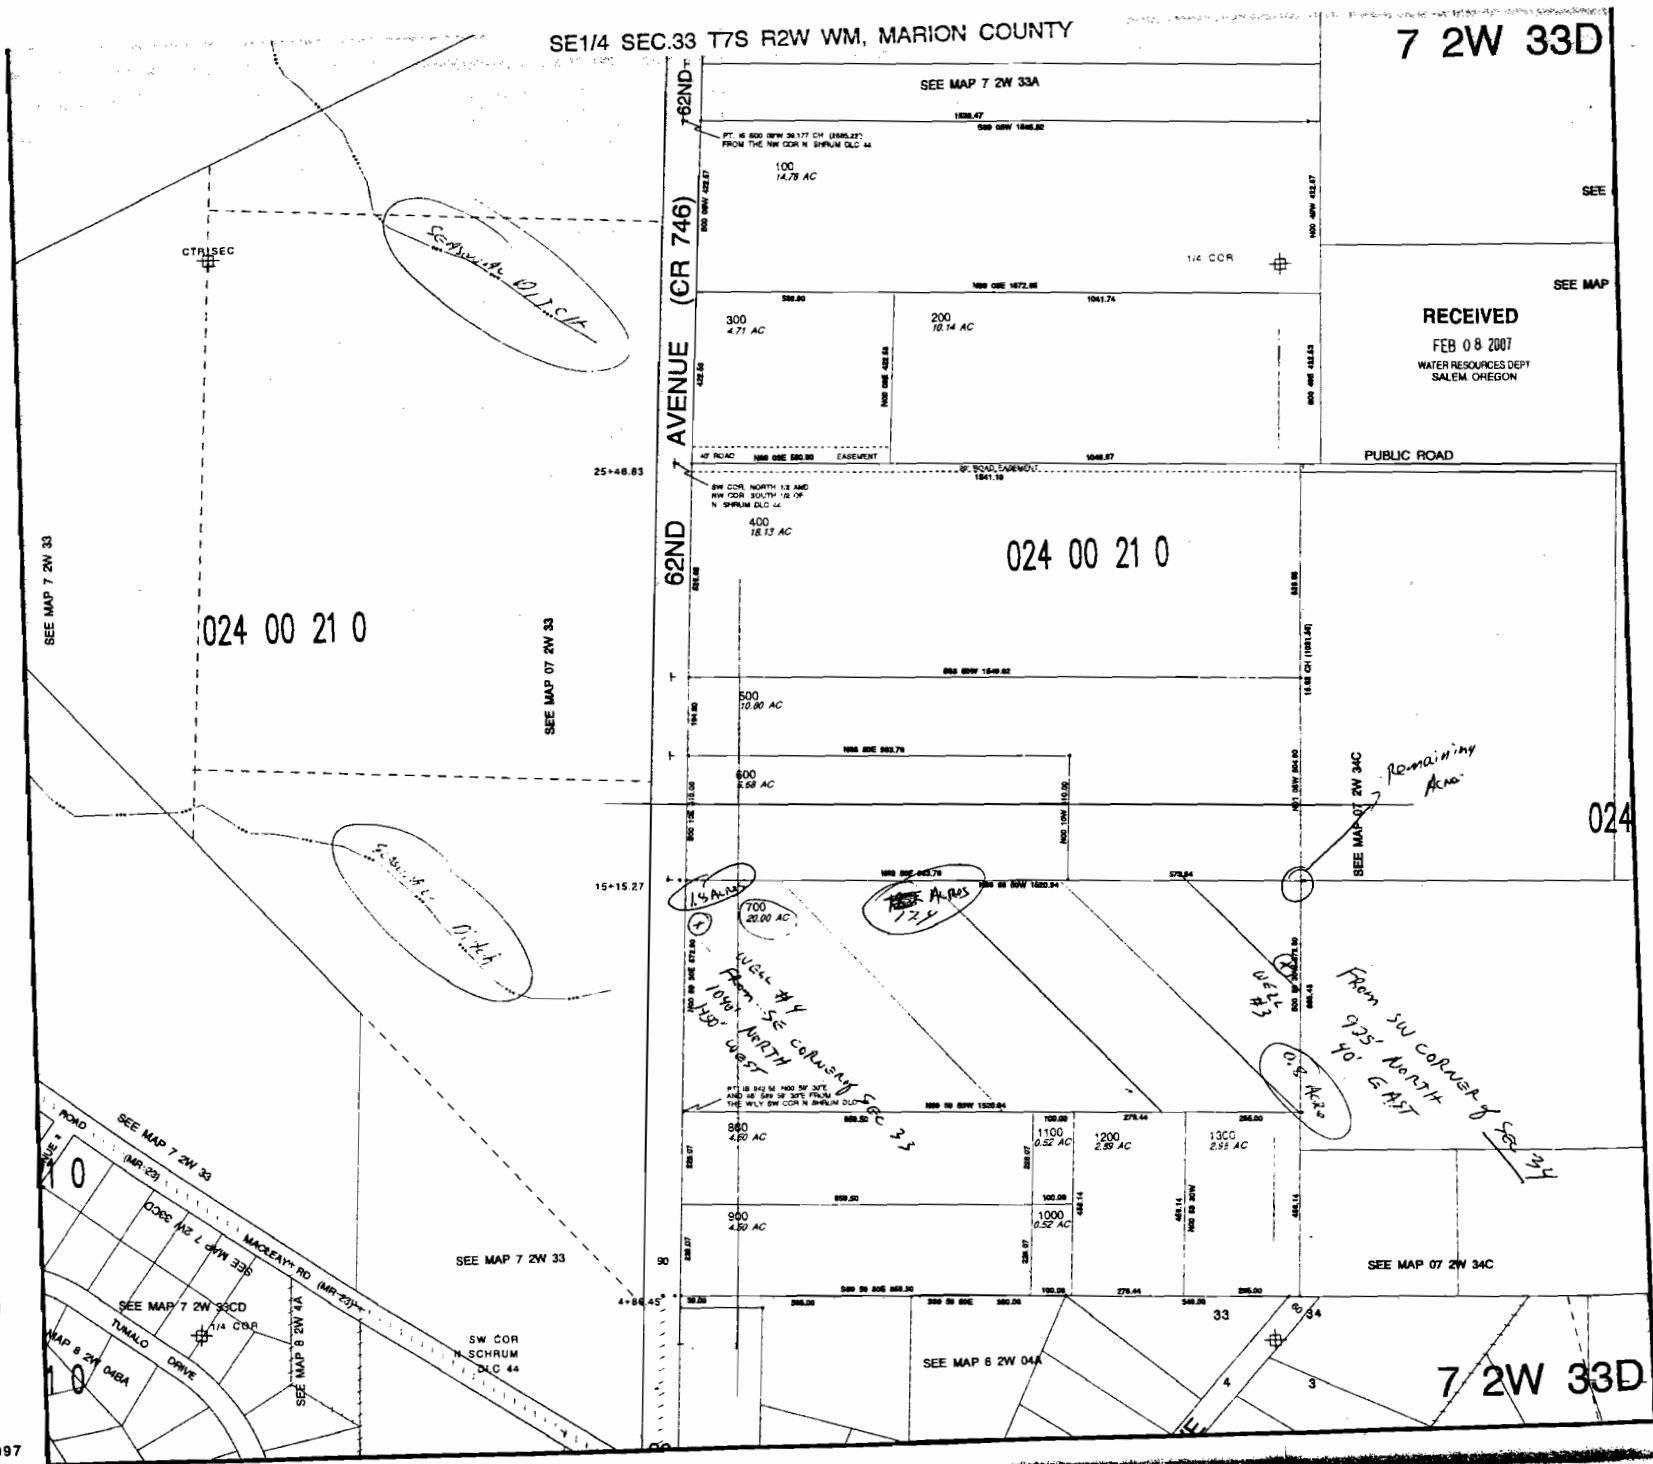

reduced copy